


TIN. R IOW. W.M.

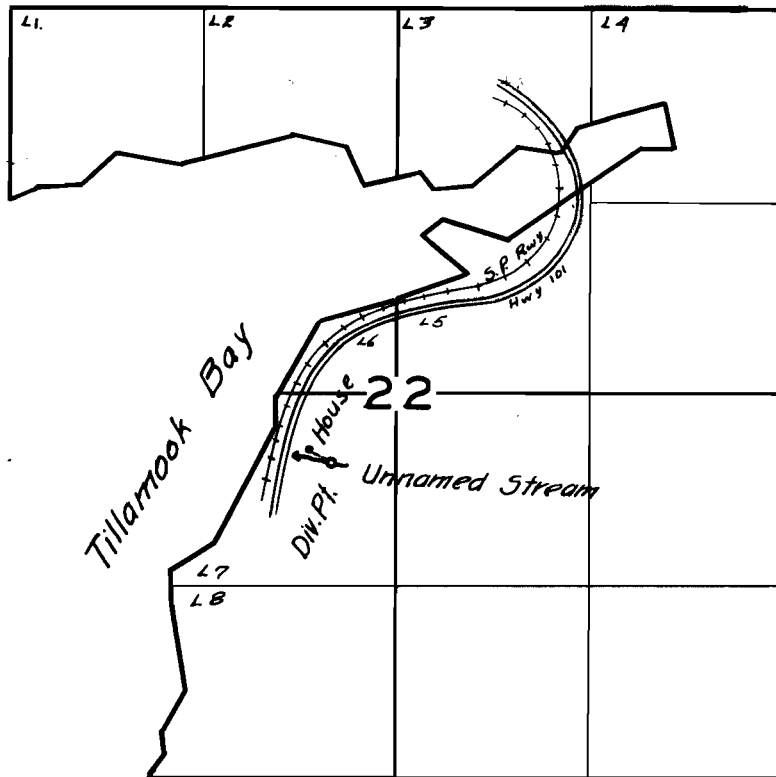

FINAL PROOF SURVEY

UNDER

Application No. *23166*... Permit No. *18335*

IN NAME OF

L.E. WADE

Surveyed *21 July*... 1955, by *Robert M. Reed*