


T.3#4 S. R. 3 W.W.M.

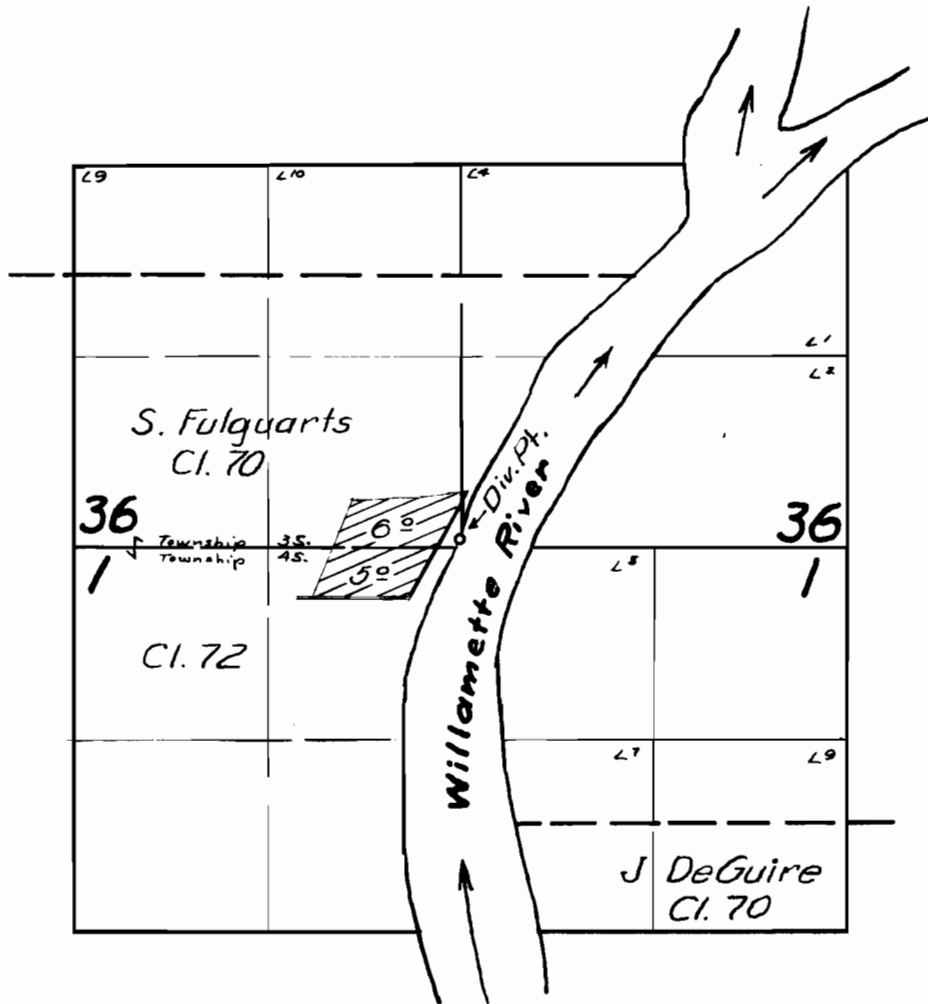

FINAL PROOF SURVEY

UNDER

Application No. 23685 Permit No. 18710

IN NAME OF

C. H. Renne

Surveyed Mar. 29 1956 by M. A. Beach