


T. 5S. R. 1W.W.M.

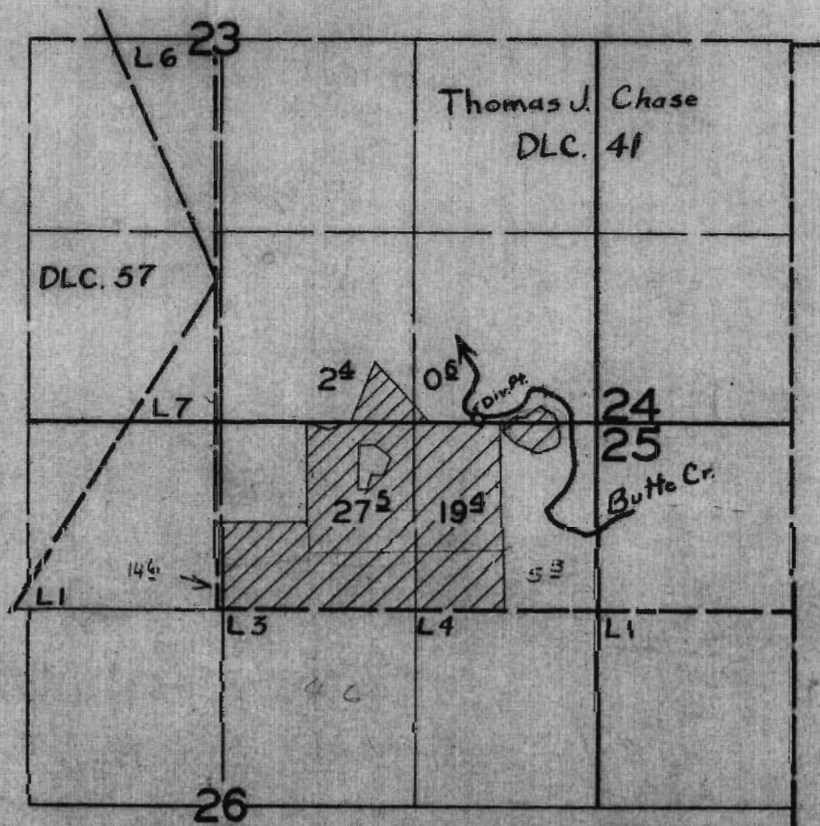

FINAL PROOF SURVEY
UNDER

Application No. 24357 Permit No. 19089

IN NAME OF

ALAN OBERSINNER

Surveyed 27 Feb. 1956, by R.D. Best