


T.26S. R.5W.W.M.

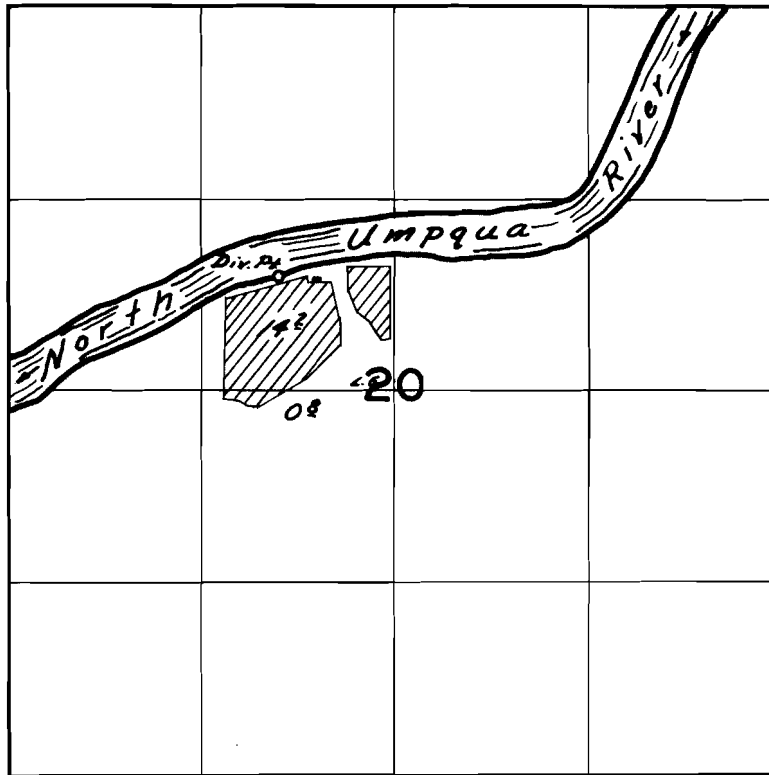

FINAL PROOF SURVEY

UNDER

Application No. *24469* Permit No. *19286*

IN NAME OF

Richard & Margaret Stritzke

Surveyed *June 7* 1956, by *C.O. Bartels*