


T. 7S. R. 1W. W.M.

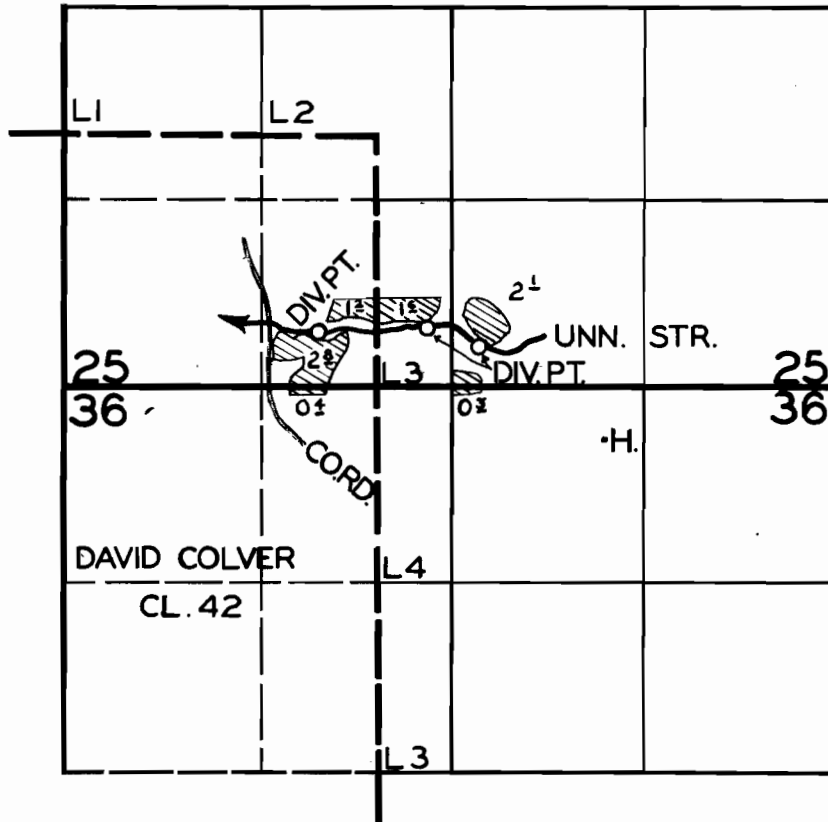

FINAL PROOF SURVEY
UNDER

Application No. 24476 Permit No. 19291.....
IN NAME OF

ARTHUR QALEY

Surveyed 2 MAR. 1956, by M. BISH.....