


T. 4 S. R. 3 W. W. M.

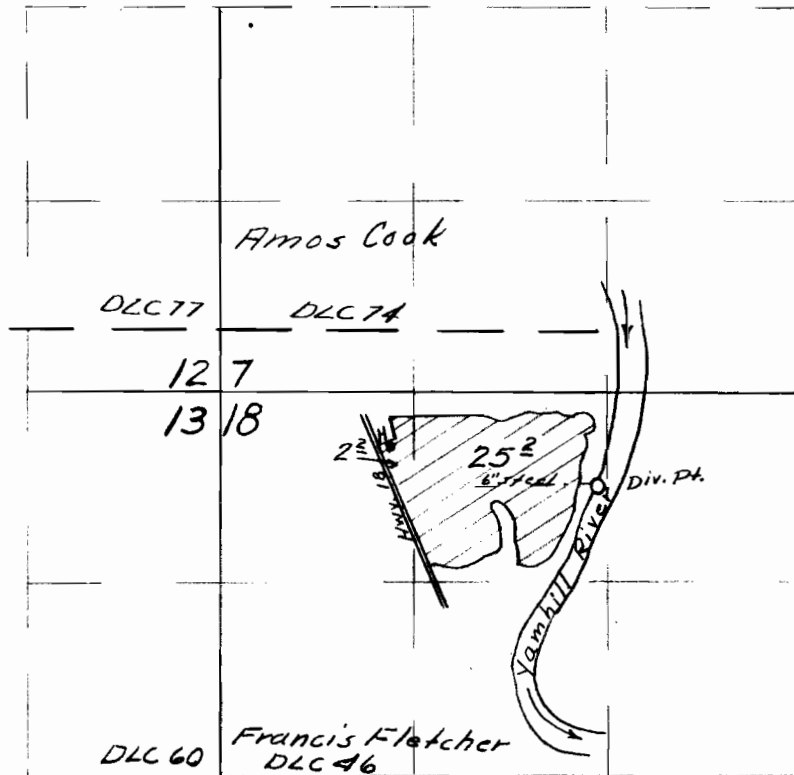

FINAL PROOF SURVEY
UNDER

Application No 24505 Permit No. 19301
IN NAME OF

Lester Leach

Surveyed May 31 1955 by T. Jones