T. 5 S. R. 4 W. W. M.

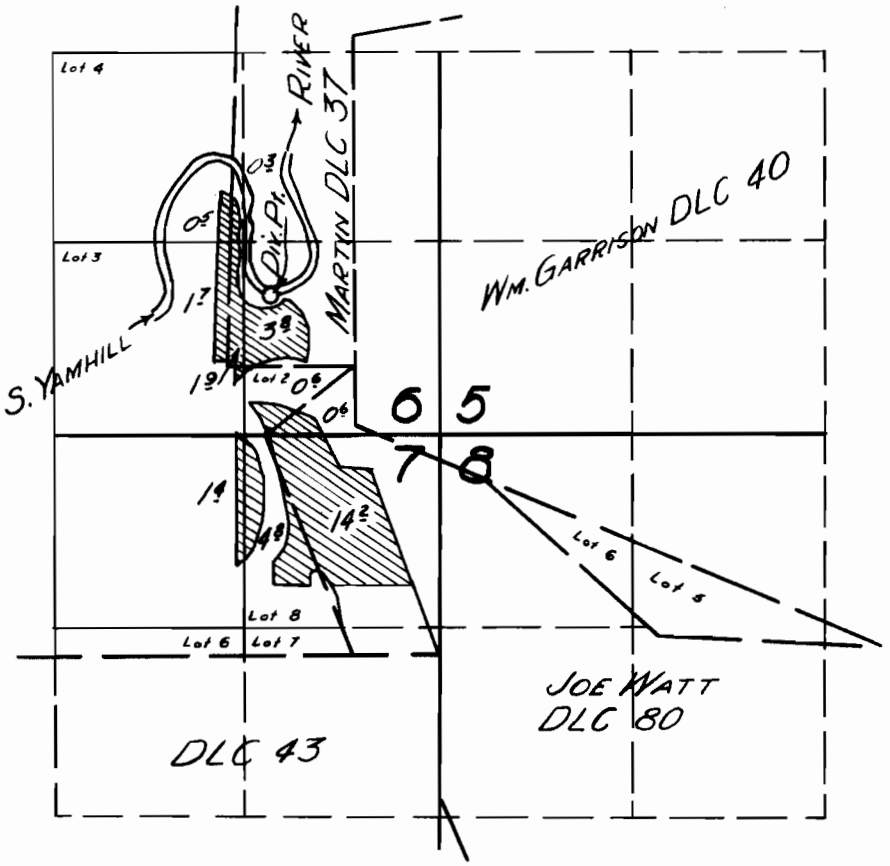

FINAL PROOF SURVEY

UNDER

Application No. 24118 Permit No. 19336

IN NAME OF

CHARLIE W. REED

Surveyed 21 Mar 1956, by [signature]

DFQ-30-70