


# SURVEYORS CERTIFICATE

I W. E. Anderson County Surveyor of Tillamook, Oregon  
do hereby certify that this map was made from notes taken  
in April 1950, and that the monument shown on this map  
consisting of an  $1\frac{1}{2}$  galv pipe is 571.77' South and 1484.6' West of  
the  $\frac{1}{4}$  corner between Sec 22 & 27. T.1N. & 10.W.W.M.

W. E. Anderson

$\frac{1}{4}$  cor 00'W 00'S  
SEC 22. T.1N. R.10.W.W.M.  
SEC 27. T.1N. R.10.W.W.M.

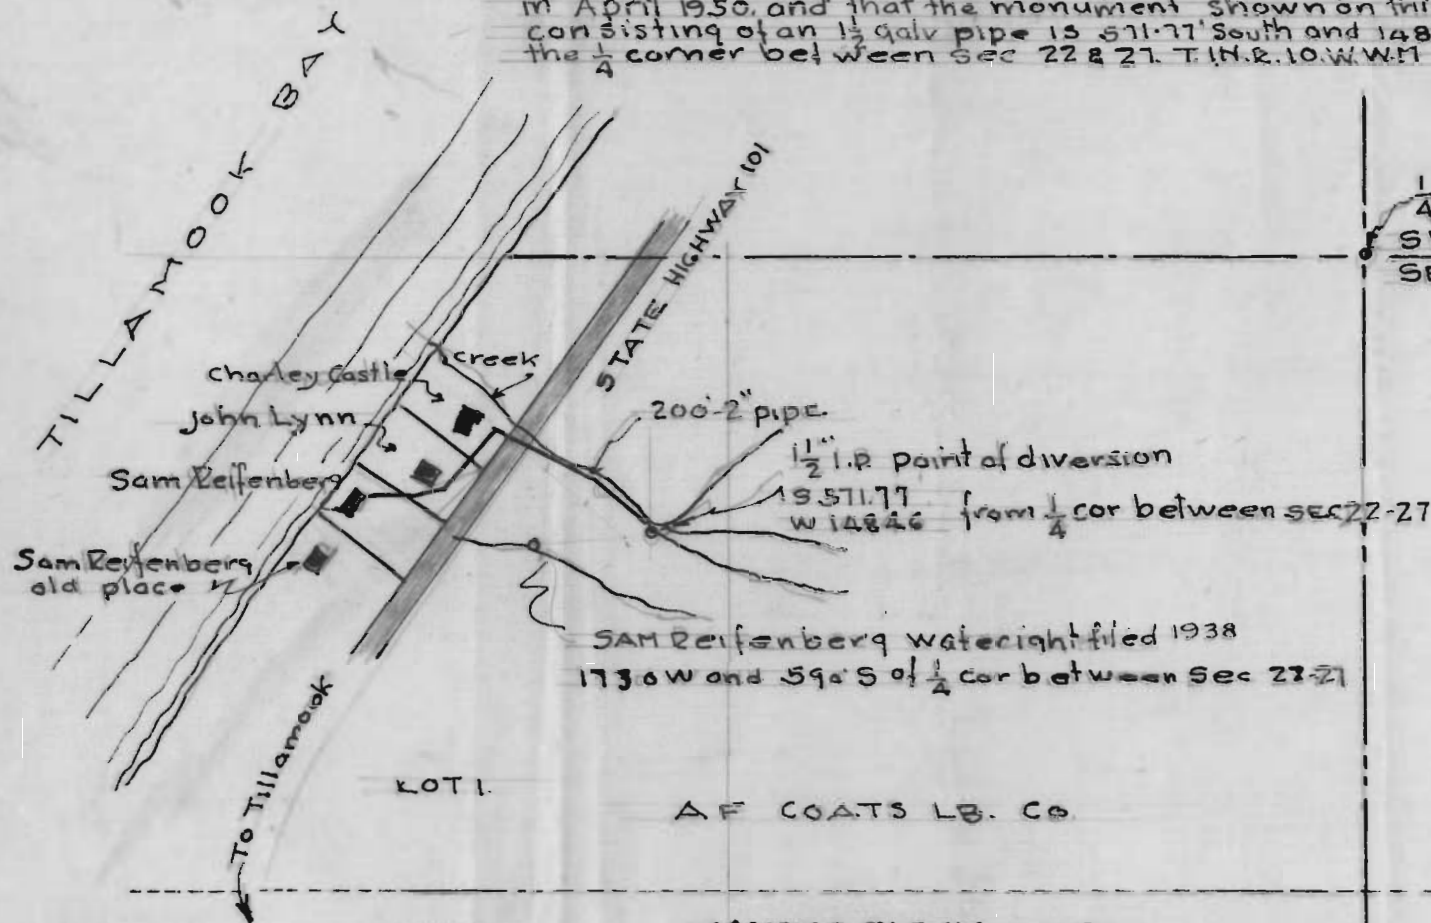

**RECEIVED**  
MAY 9 1950  
STATE ENGINEER  
SALEM, OREGON

LOT 1.  
AF COATS LB. CO.  
LOT 2.  
**WATER RIGHT FOR**  
**CHARLEY CASTLE-SAM REIFENBERG-JOHN LYNN**  
LOCATED IN GOVT LOT 1, SEC 27. T.1N. R.10.W.W.M.  
TILLAMOOK OREGON  
SCALE 1"=400'

Application No. 24707  
Permit No. 19417

24707 1-6F