T. 7S. R. 1W. W.M.

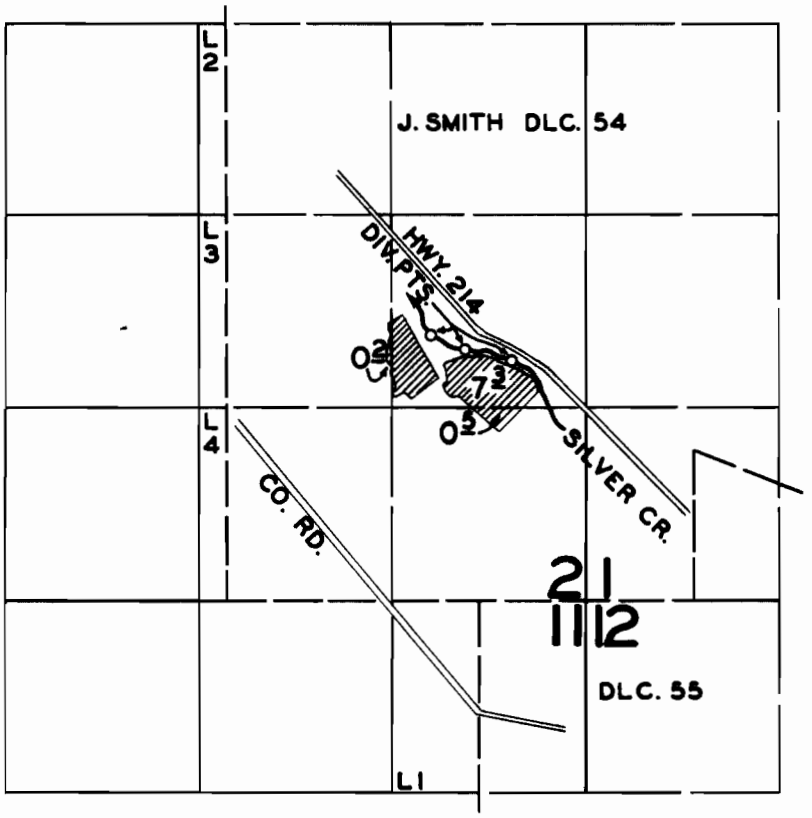

FINAL PROOF SURVEY

UNDER

Application No. 24670 Permit No. 19481

IN NAME OF

HATTIE O. COLL

Surveyed FEB. 29 1956, by M. BISH

DFN-ID-122