


T. 4 S. R. 4 & 5 W. W. M.

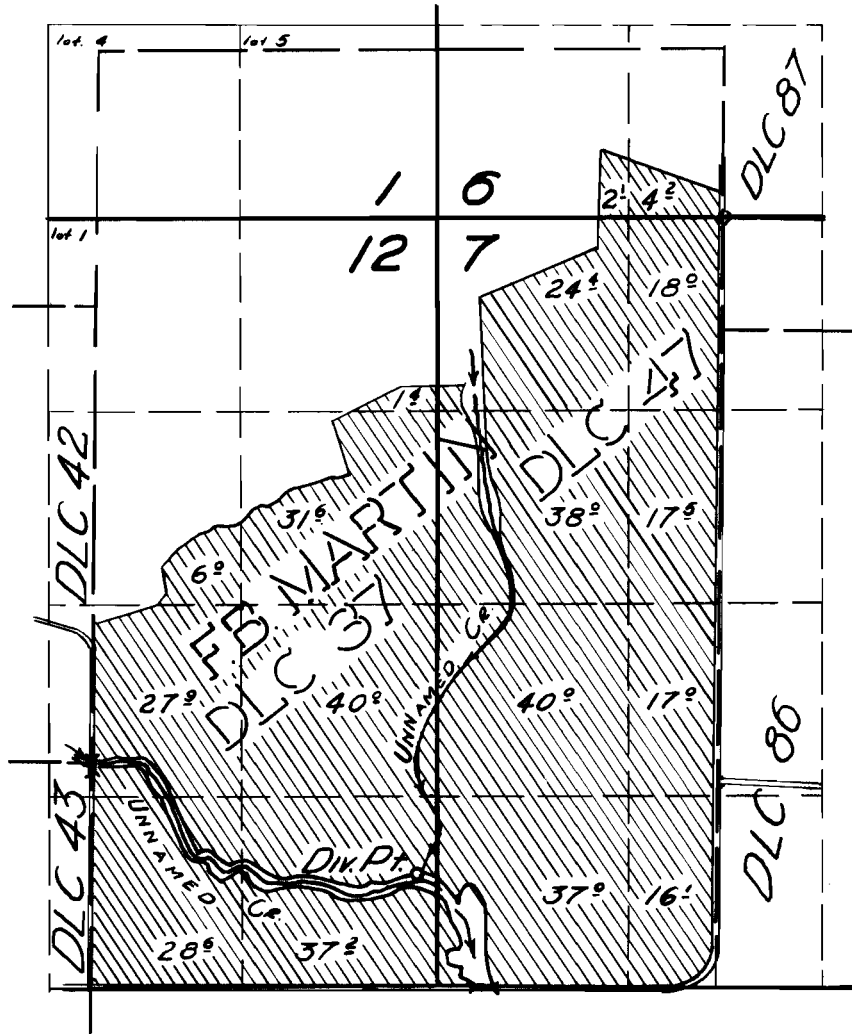

FINAL PROOF SURVEY

UNDER

Application No. 24750 Permit No. 19513

IN NAME OF

L. F. SETNIKER

Surveyed 6 Mar. 1956, by [Signature]