


T1&2N, R4 W, WM.

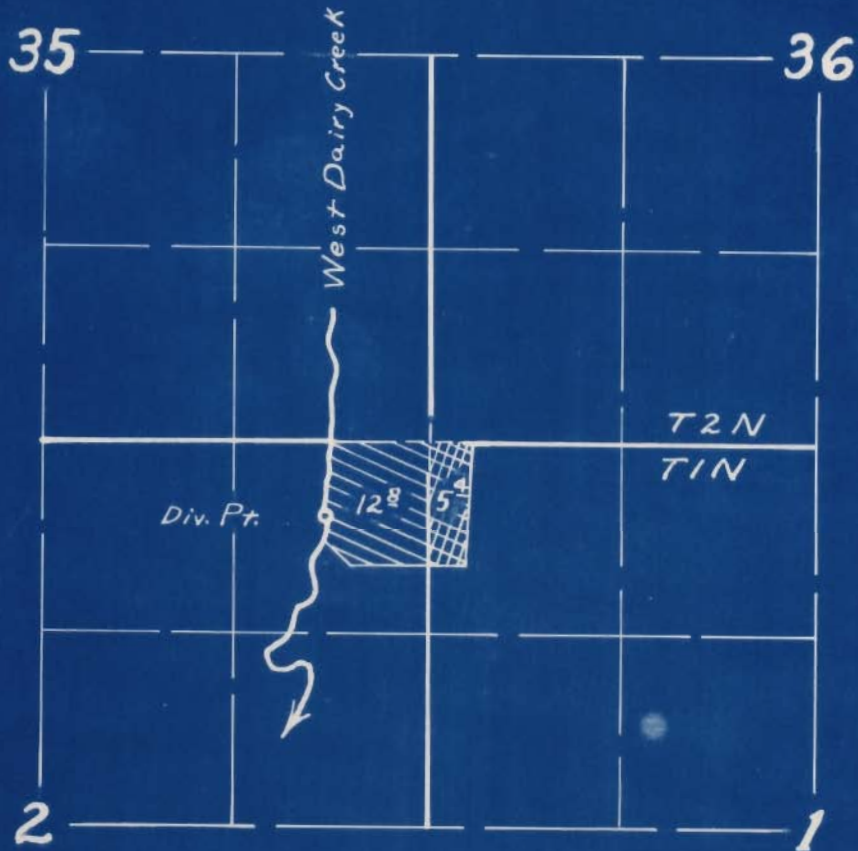

FINAL PROOF SURVEY

UNDER

23702

18718

Application No. 24782 Permit No. 19526

IN NAME OF

W^m L. Moore

Surveyed 4-12 1956, by R.H. Whitby

