


T1S, R4W, WM

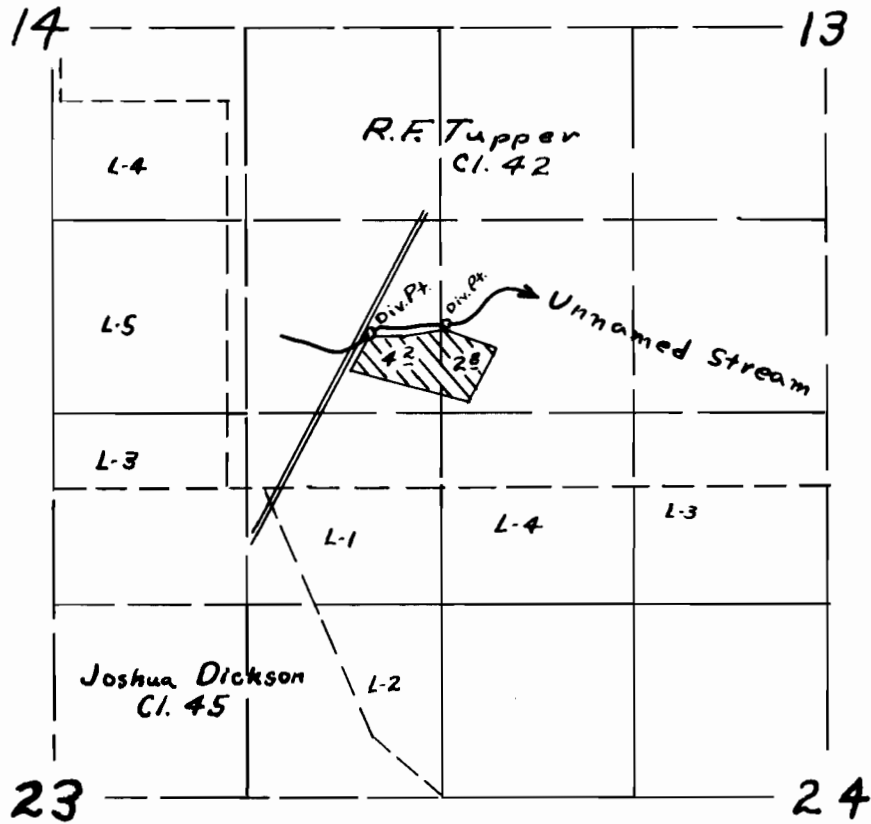

**FINAL PROOF SURVEY**

UNDER

Application No. 24773 Permit No. 19667

IN NAME OF

Edith June Walker & Clara Thompson Walker

Surveyed 4-19 1956, by R.D. Best