T. 4 S. R. 5 W. W. M.

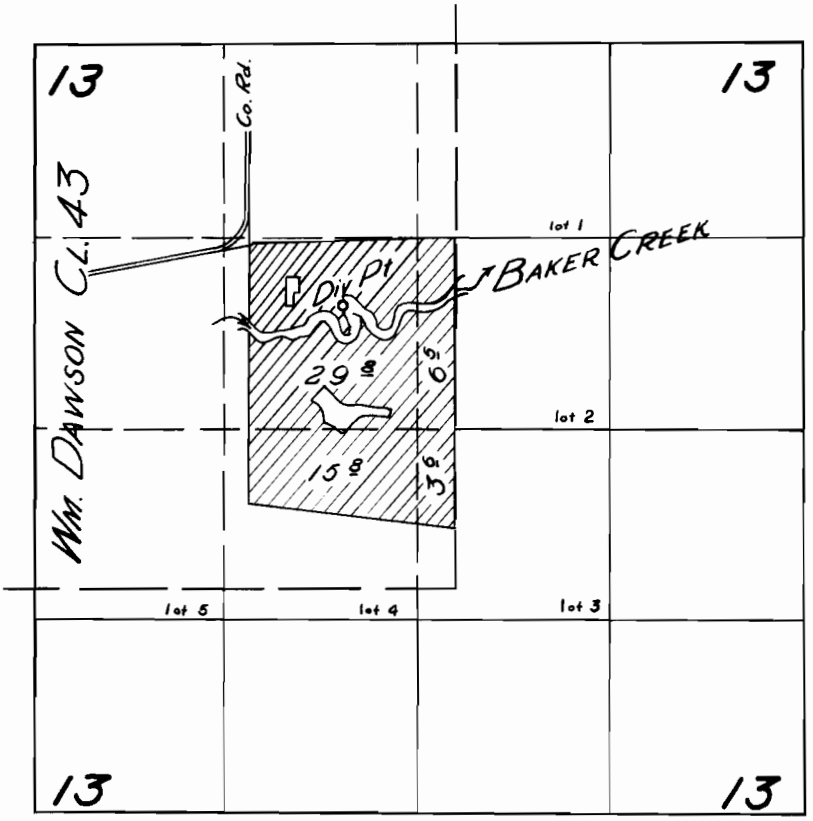

FINAL PROOF SURVEY

UNDER

Application No. 25045 Permit No. 19729

IN NAME OF

R. W. BROWN

Surveyed 29 Mar. 1956, by C. W. Whitby

DFQ-3D-65