


T. IN. R. 10 W. WM

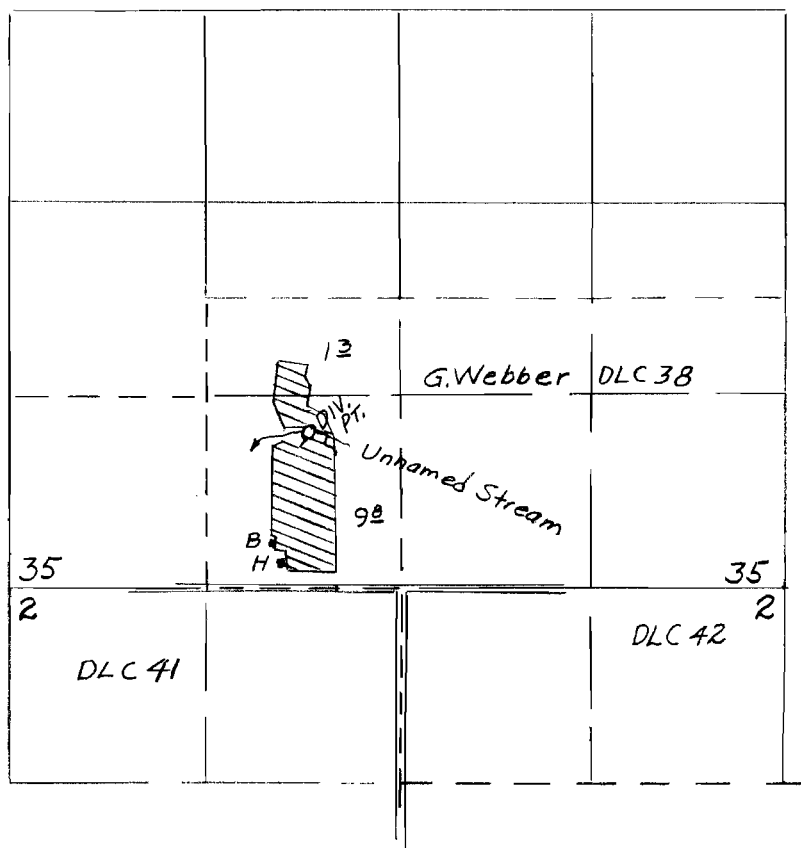

FINAL PROOF SURVEY

Under

Application No. 25190 Perinit No 19805
In name of

F.A. & Elsie Neal

Surveyed July 20, 1955 by R.D. Best

1955V