


T. 7 S. R. 1 W. W. M.

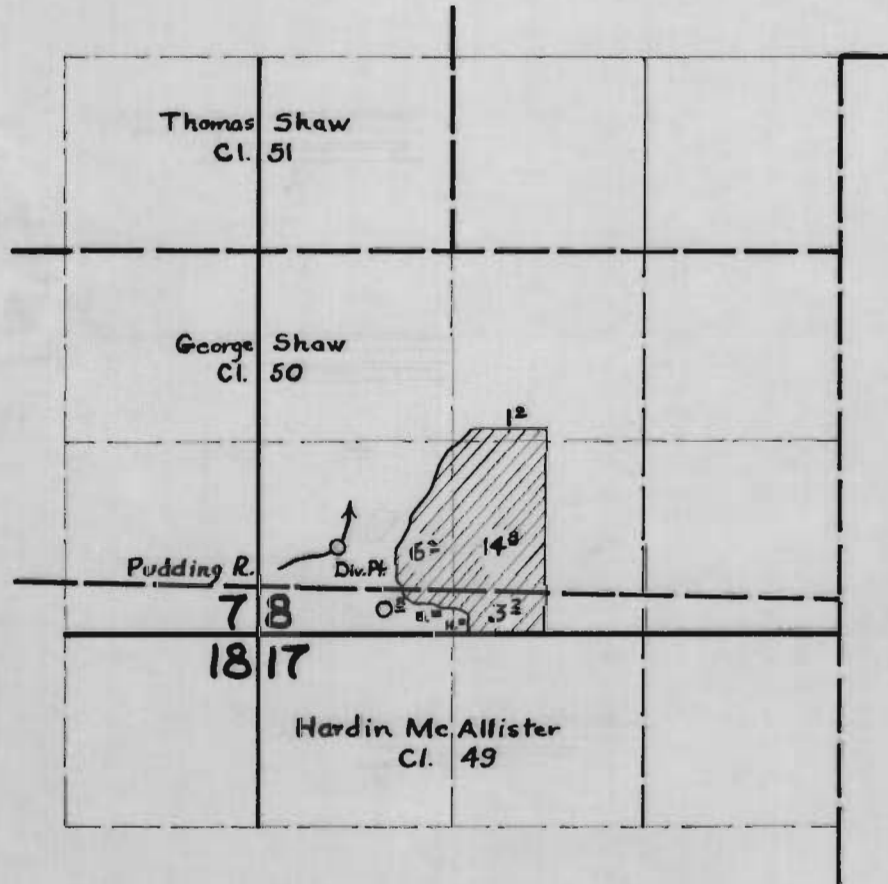

FINAL PROOF SURVEY

UNDER

Application No. 25202 Permit No. 19811

IN NAME OF

BEN KAUFMAN

Surveyed 1 Apr. 1956, by M. Bish