


T. 24 S. R. 3 W. W.M.

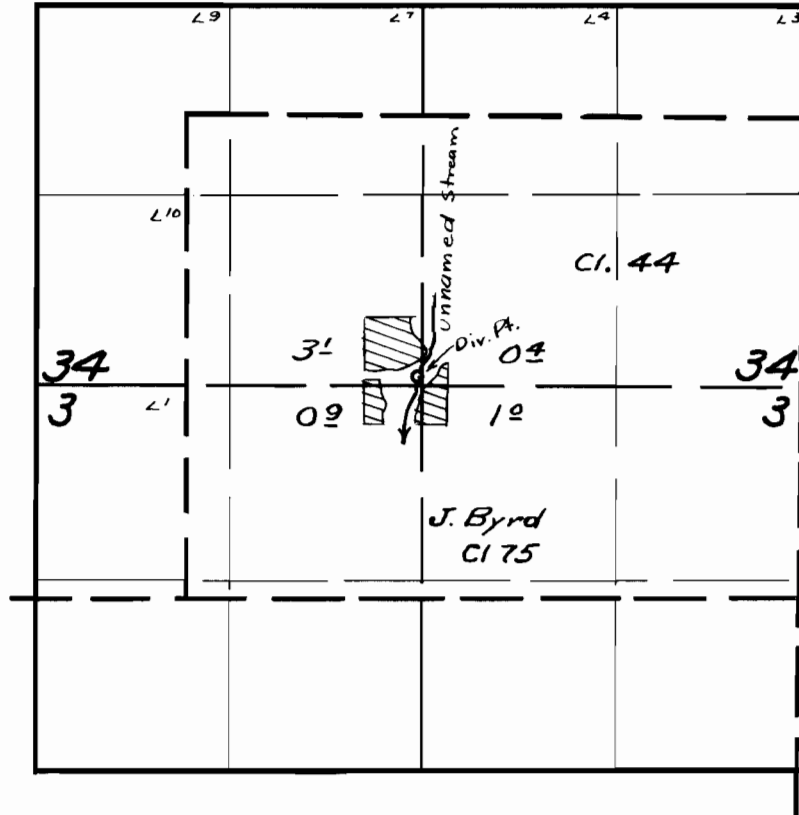

FINAL PROOF SURVEY
UNDER

Application No. 24860 Permit No. 19936

IN NAME OF

Nelson K. Rothrock

Surveyed Mar 20 1956, by Tr. Bish