


T. 4 S. R. 4 W. W.M.

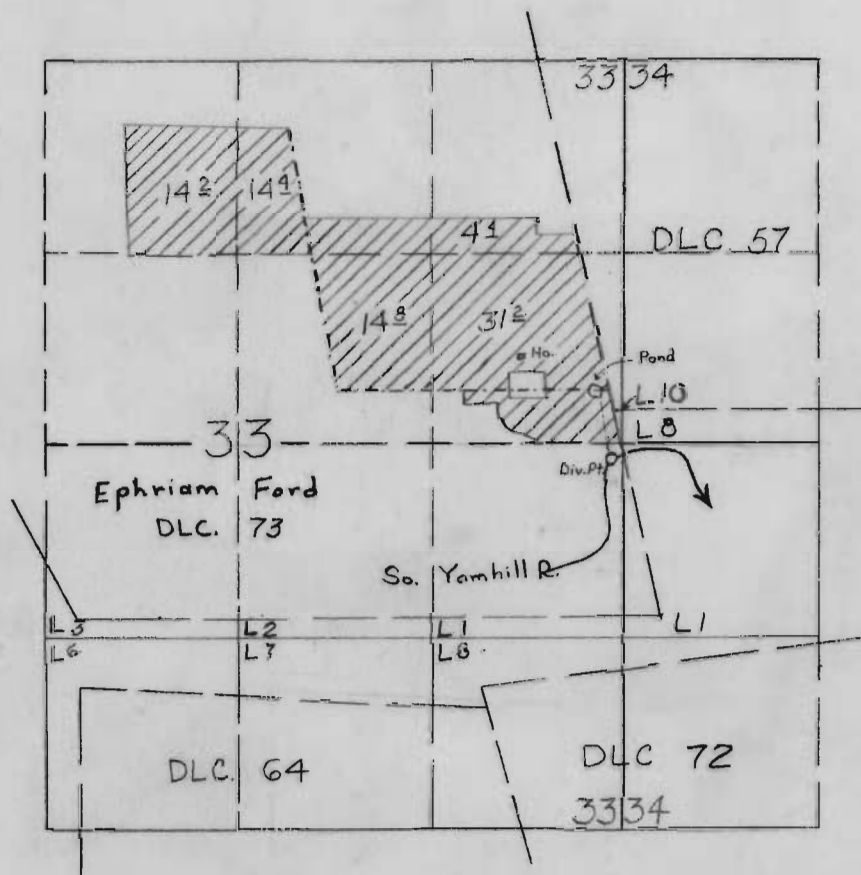

FINAL PROOF SURVEY
UNDER

Application No. 25544 Permit No. 20058
IN NAME OF

Dick Reyne

Surveyed 9 June 1955 by T. Jones