


T.23S. R.7W.W.M.

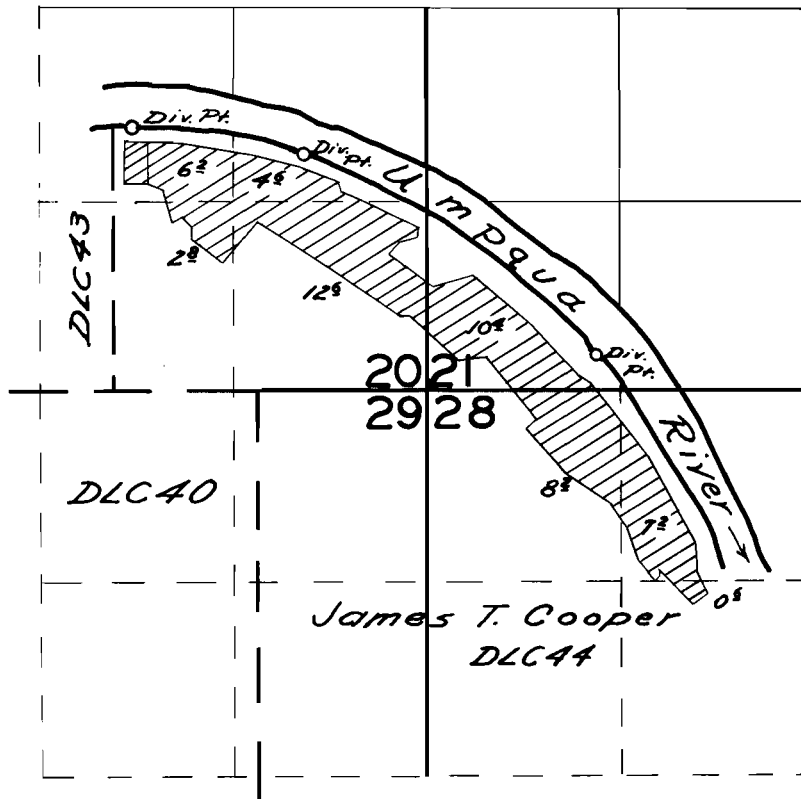

FINAL PROOF SURVEY

UNDER

Application No. *25701* Permit No. *20139*

IN NAME OF

P. W. George

Surveyed *July 1, 1956* by *C. O. Bartels*