


T. 5 S. R. 3 W. W.M.

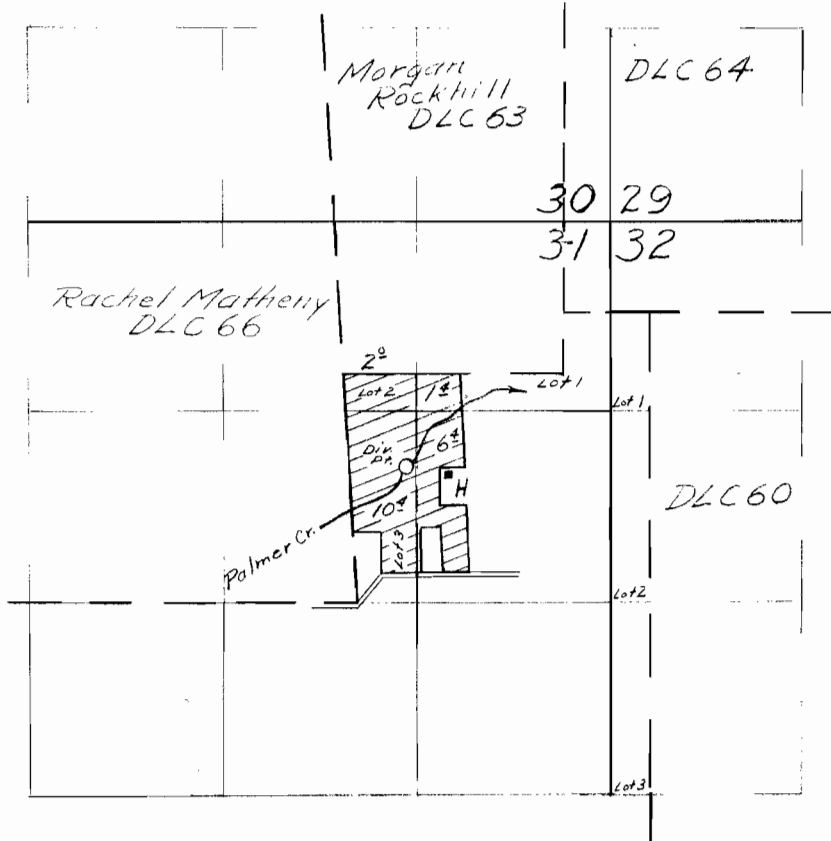

Final Proof Survey
Under

Application No. 25195 Permit No. 20172
In Name of

H. Vernon Stephens

Surveyed May 24 1955 by T. Jones