


Range 24 E.W.M.

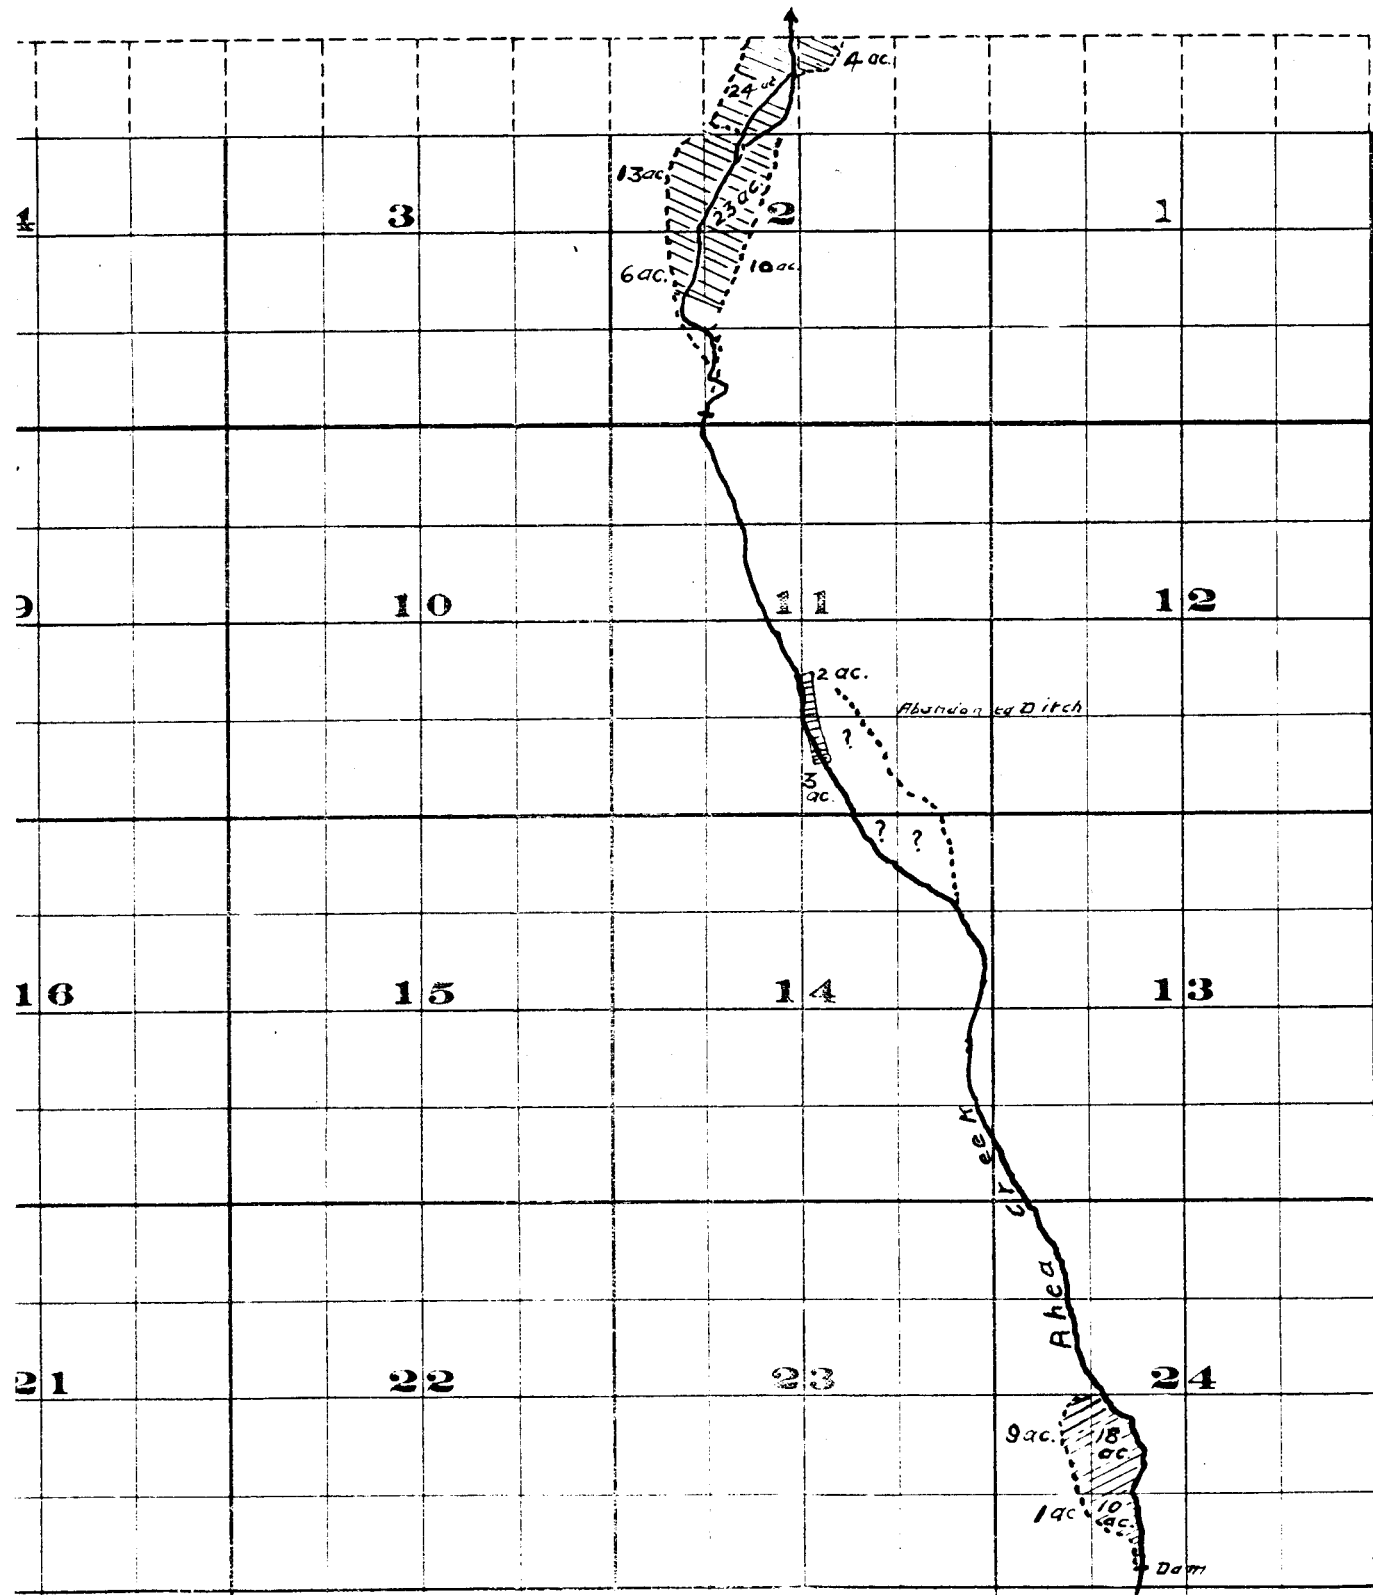


7	8	9	10
18	17	16	15
19	20	21	22
30	29	28	27
31	32	33	34

THE S. A. PRISTOL CO. PRINTED IN THE U.S.A.

Surveyed by R.D. Cooper July 1909

John H. Lewis - State Engineer.

Examined July 14, 1909.

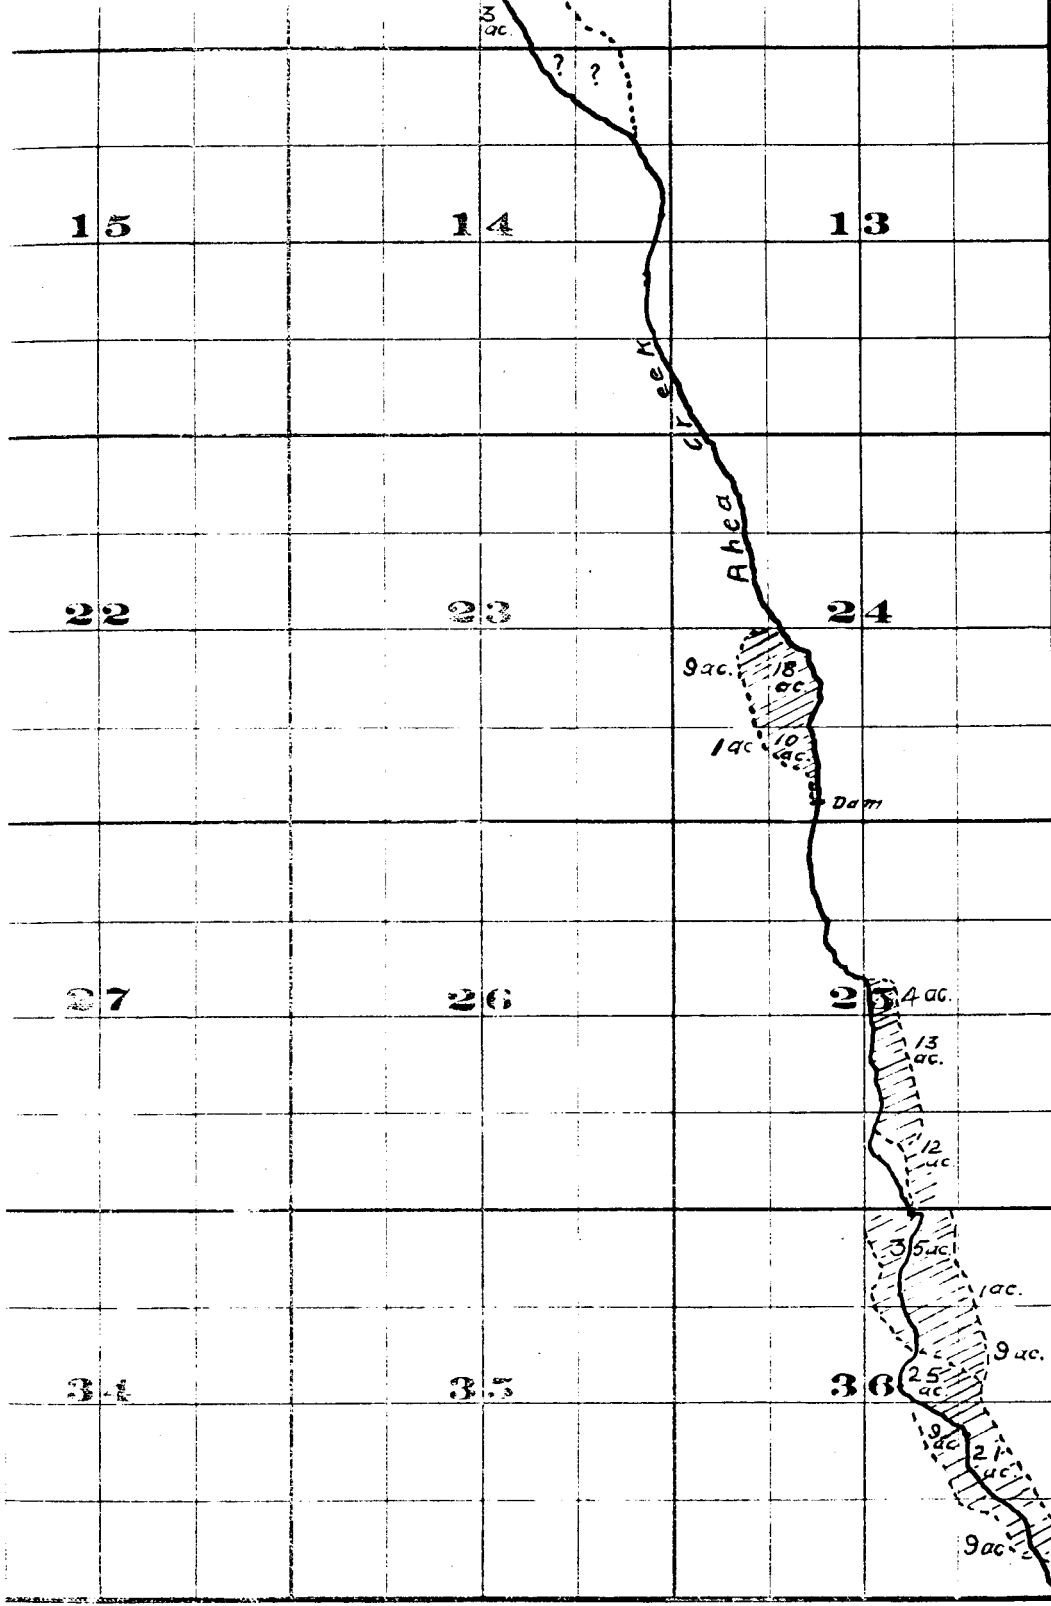

FROM OFFICE OF THE STATE ENGINEER, SALEM, OREGON

Willow Creek Adjudication.

2 S. 24 E.