


T. 7 S. 1 W. W.M.

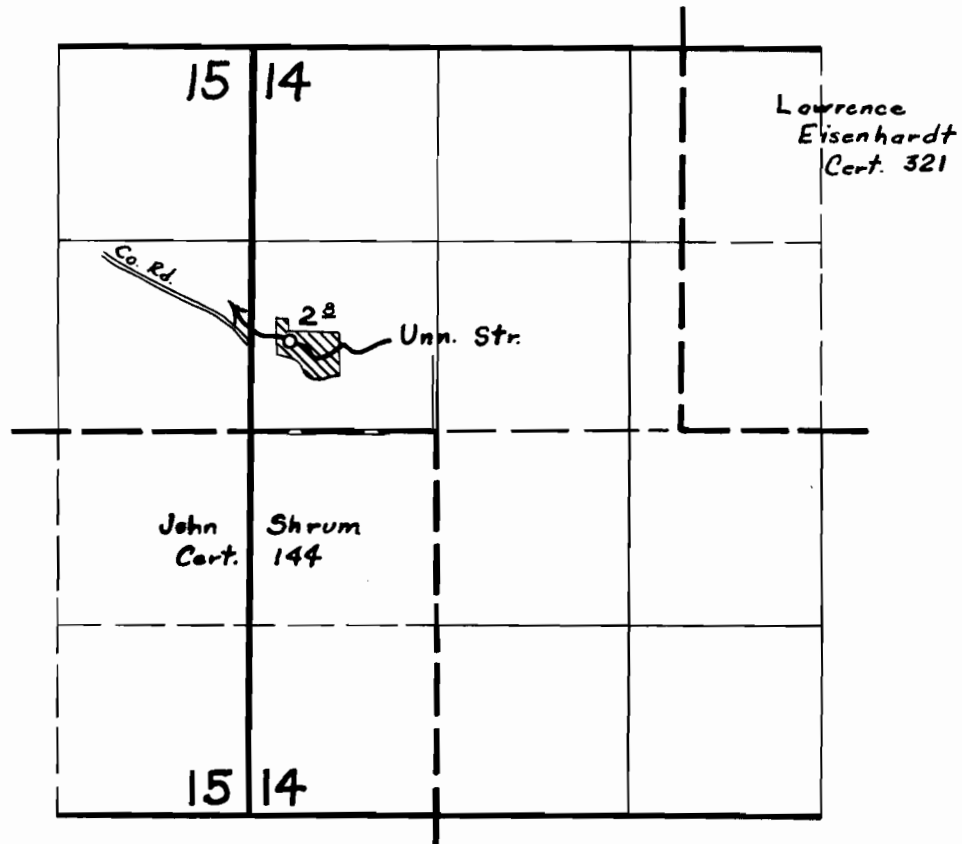

FINAL PROOF SURVEY
UNDER

Application No. 26258 Permit No. 20610

IN NAME OF

MARGARET KLOPFENSTEIN

Surveyed 1 Mar. 1956, by M. Bish