


T. 1 S. R. 21 E. W. M.

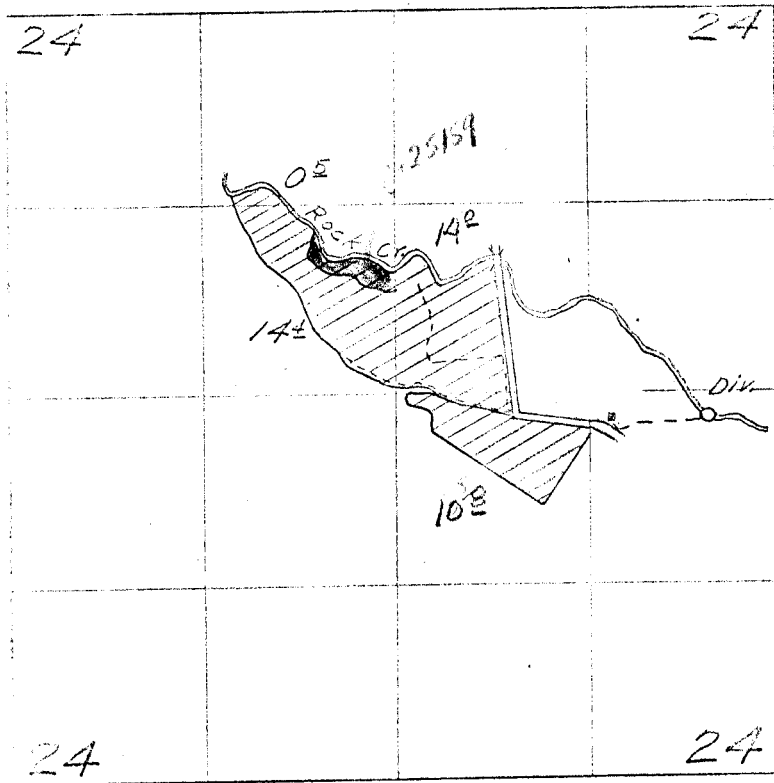

Final Proof Survey
Under

Application No. 26436 Permit No. 20730
In Name Of

Orie L. Conboy

Surveyed April 16, 1955 by T. Jones