


T.5 S. R. 4 W. W.M.

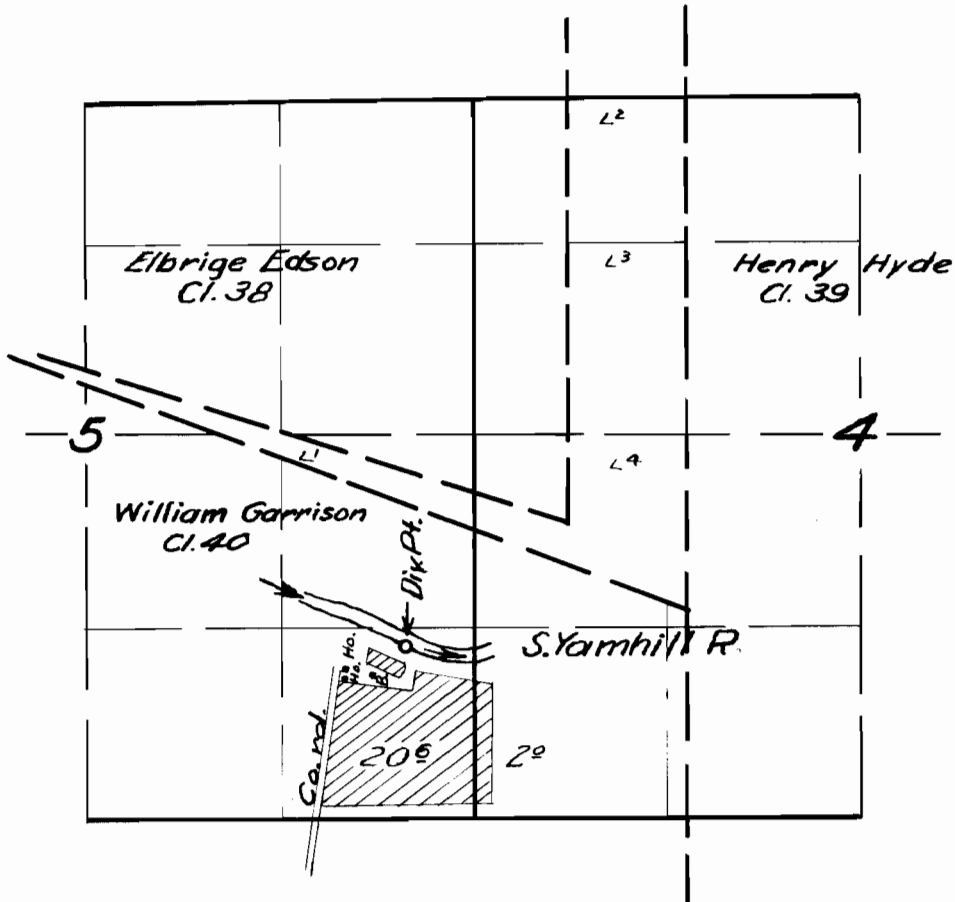

FINAL PROOF SURVEY

UNDER

Application No. 26473 Permit No. 20751

IN NAME OF

Alvin Weirich

Surveyed Mar. 15 1956, by J. M. Bish