


T. 4 S. R. 5 W. W.M.

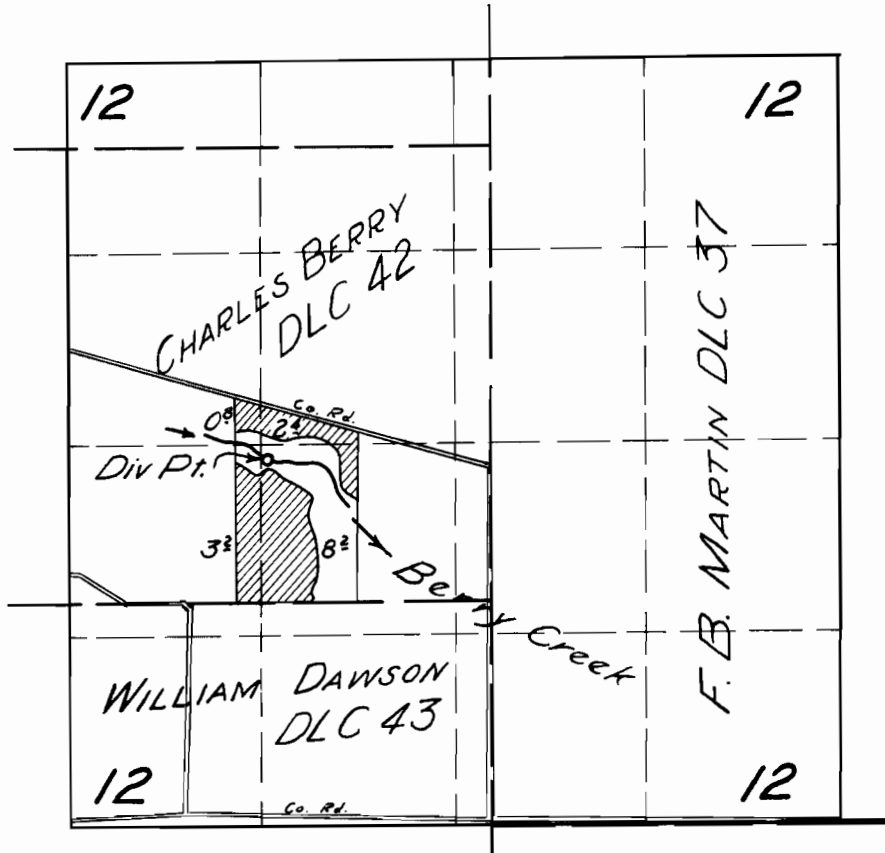

FINAL PROOF SURVEY
UNDER

Application No. 26516 Permit No. 20783
IN NAME OF

ANTON J. PAULSON

Surveyed 19 Mar. 1956, by [Signature]