


T. 4 S. R. 3 W. W. M

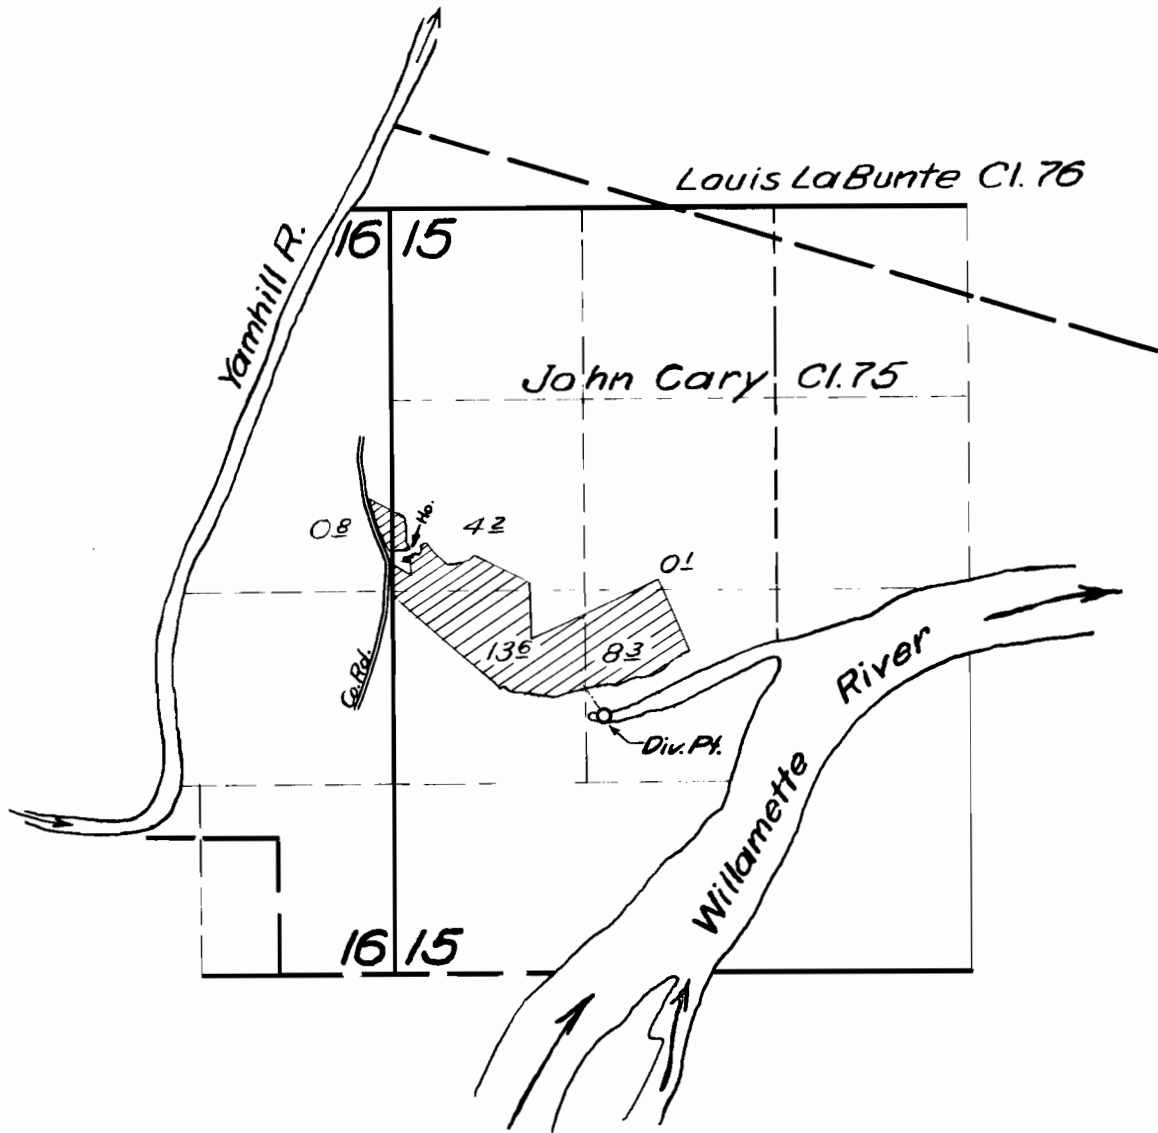

FINAL PROOF SURVEY  
UNDER

Application No. 26572 Permit No. 20820  
IN NAME OF

*Harry E. Fortner*

Surveyed *Mar 8 1956* by *M. Bish*