


T1&2N,R4W,WM.

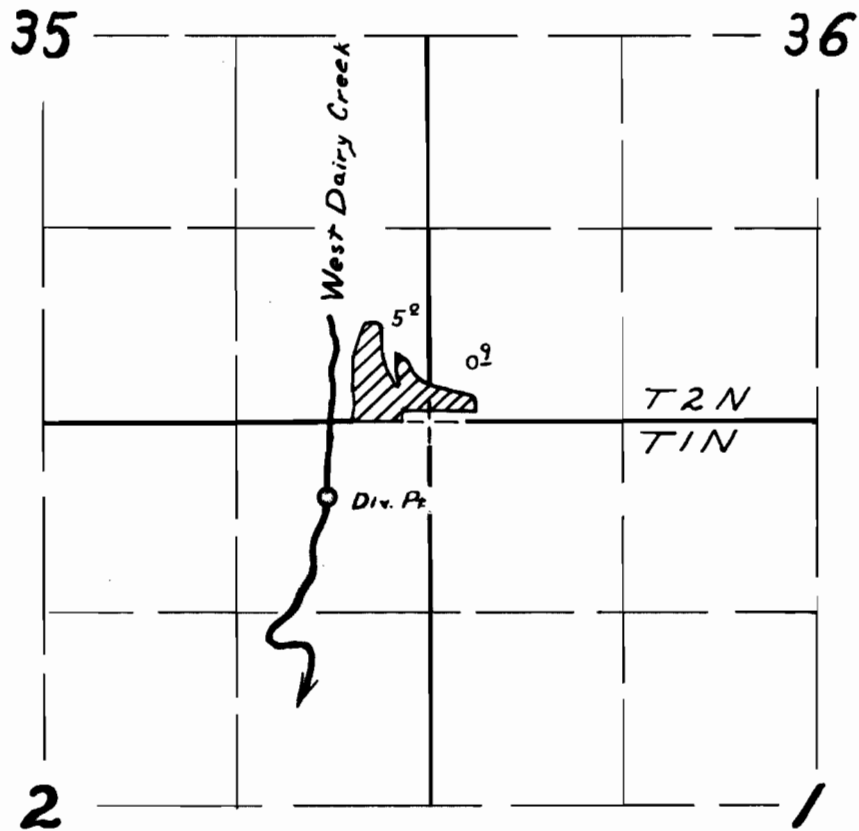

**FINAL PROOF SURVEY**  
UNDER

Application No. 26885 Permit No. 21108

IN NAME OF

Moore Company

Surveyed 4-17 1956, by RDBest