


T. 5 & 6 S. R. 5 W. W. M.

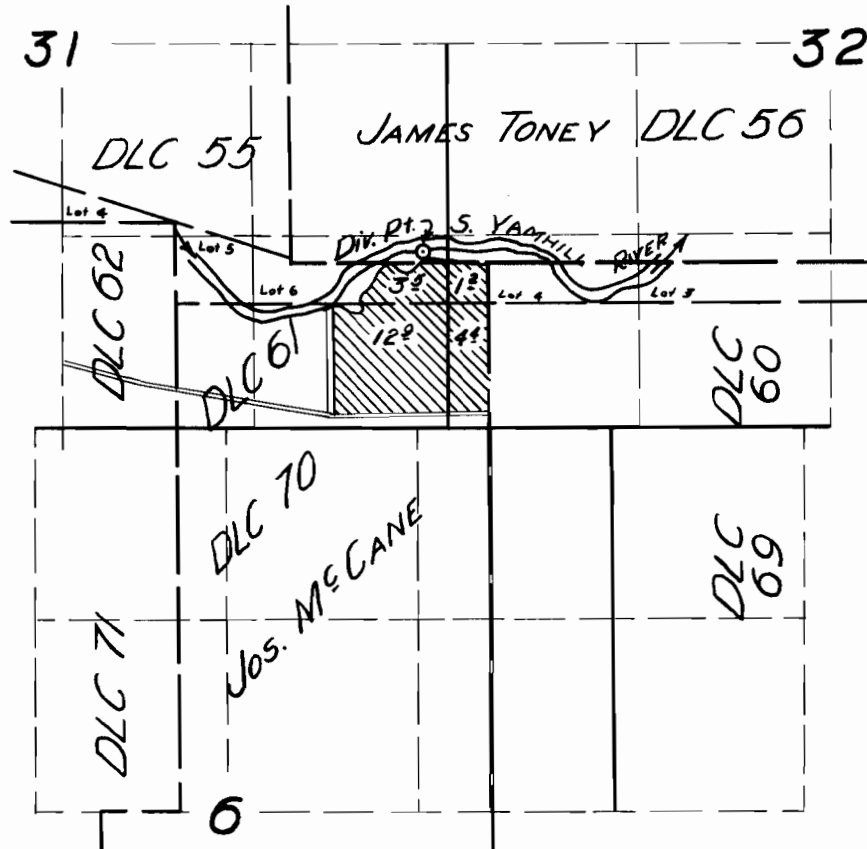

FINAL PROOF SURVEY

UNDER

Application No. 26904 Permit No. 21141

IN NAME OF

GEORGE LUX

Surveyed 21 Mar. 1956, by *[Signature]*