


T.4 S. R. 4 W. W.M.

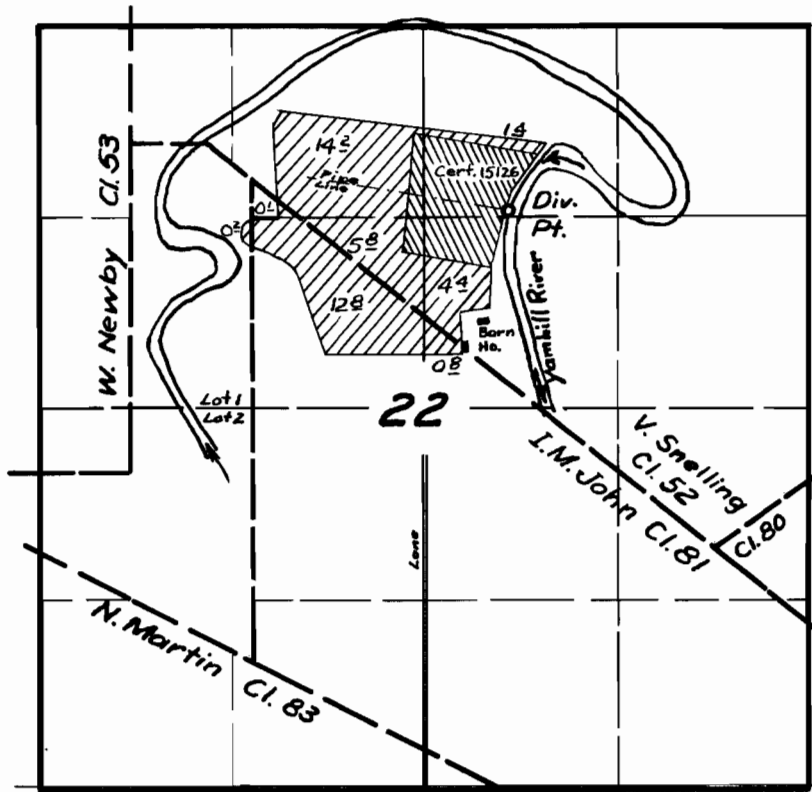

**FINAL PROOF SURVEY**

UNDER

Application No. 26913 Permit No. 21148

IN NAME OF

Eddie E. Sohrweid

Surveyed Mar. 8 1956, by Tr. Bish