


T.26S. R.8W.W.M.

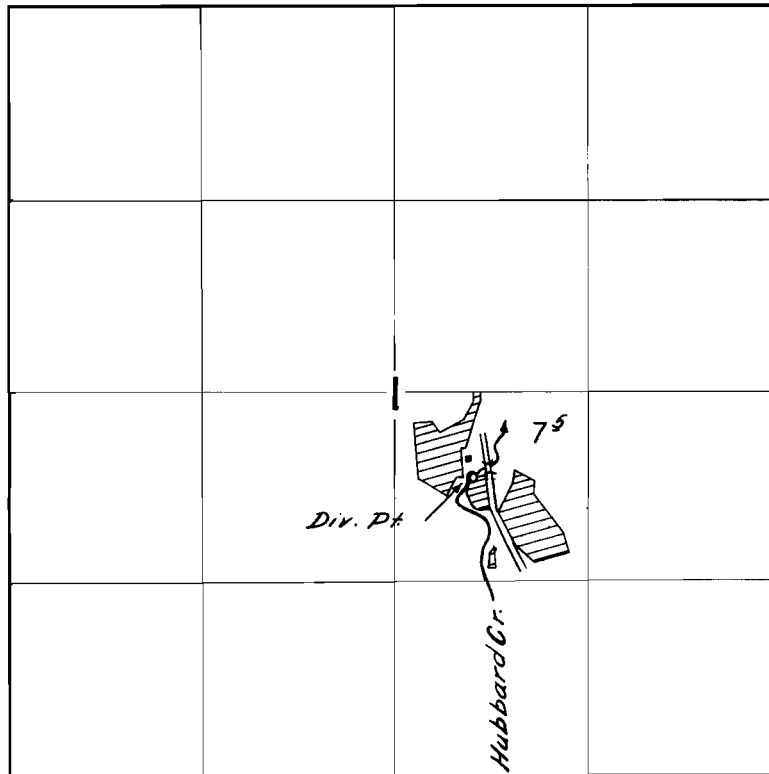

FINAL PROOF SURVEY
UNDER

Application No. 27176 Permit No. 21372
IN NAME OF

Roy E. & Thelma Darvult

Surveyed Aug. 24, 1956, by C. O. Bartels