


T. 7 S. R. 1 W. W.M.

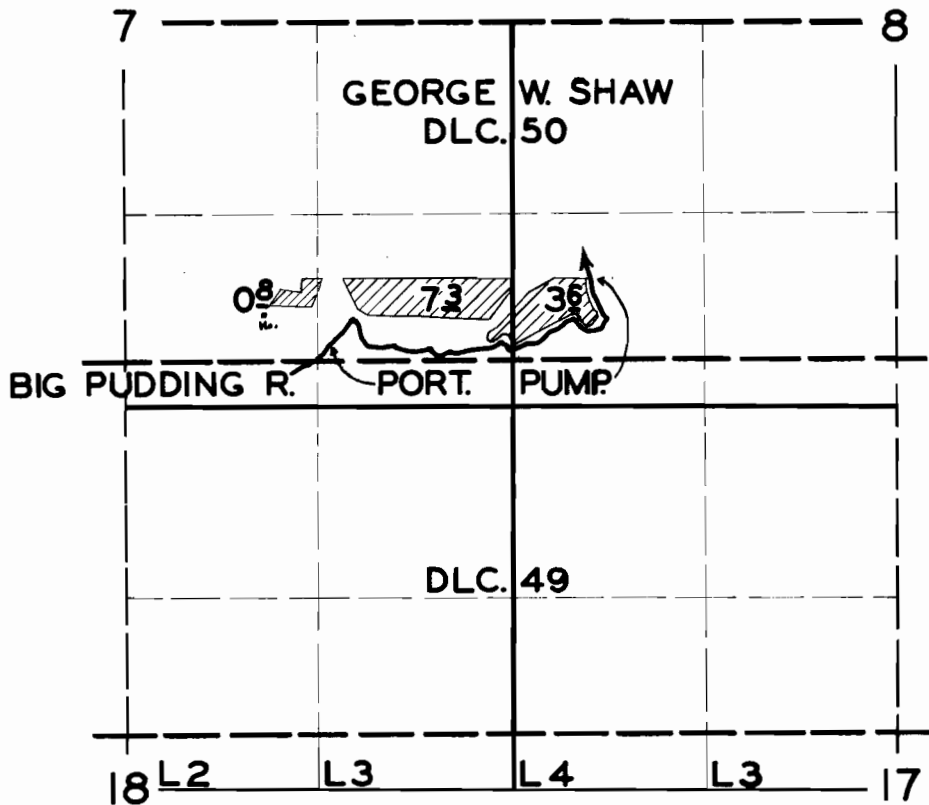

**FINAL PROOF SURVEY**

UNDER

Application No. **27254** Permit No. **21442**

IN NAME OF

**ELDON S. ALT**

Surveyed **5 APR. 1956**, by **M. BISH**

*msb*