


T.22S. R.6W.W.M.

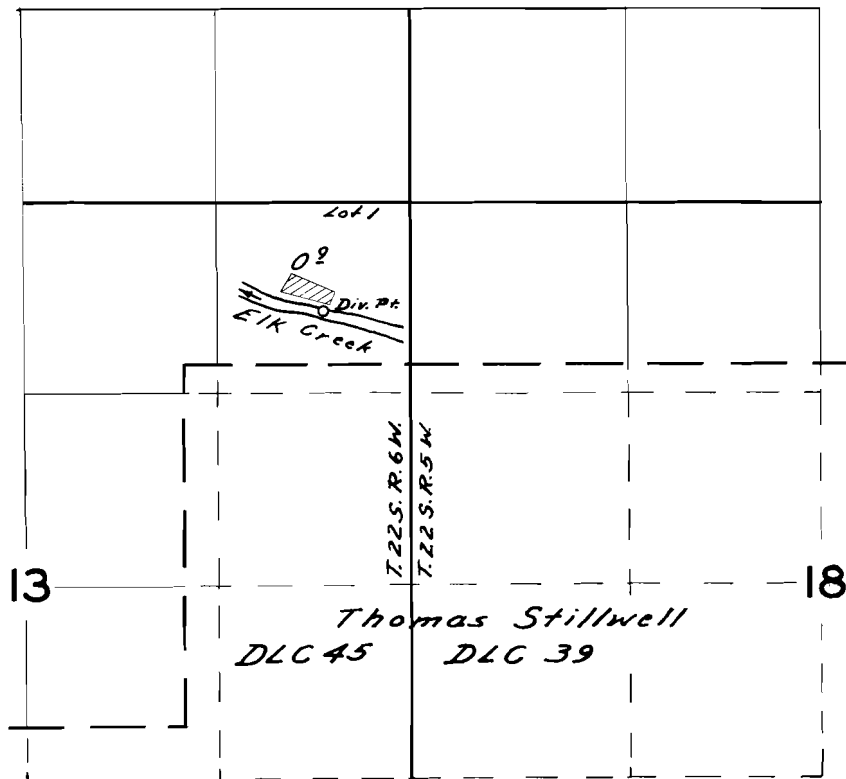

### FINAL PROOF SURVEY

UNDER

Application No. 27324 Permit No. 21484

IN NAME OF

Warren Elwood Clevenger

Surveyed June 26 1956, by C. O. Bartels