



T. 6 S. R. 1 E. W.M.

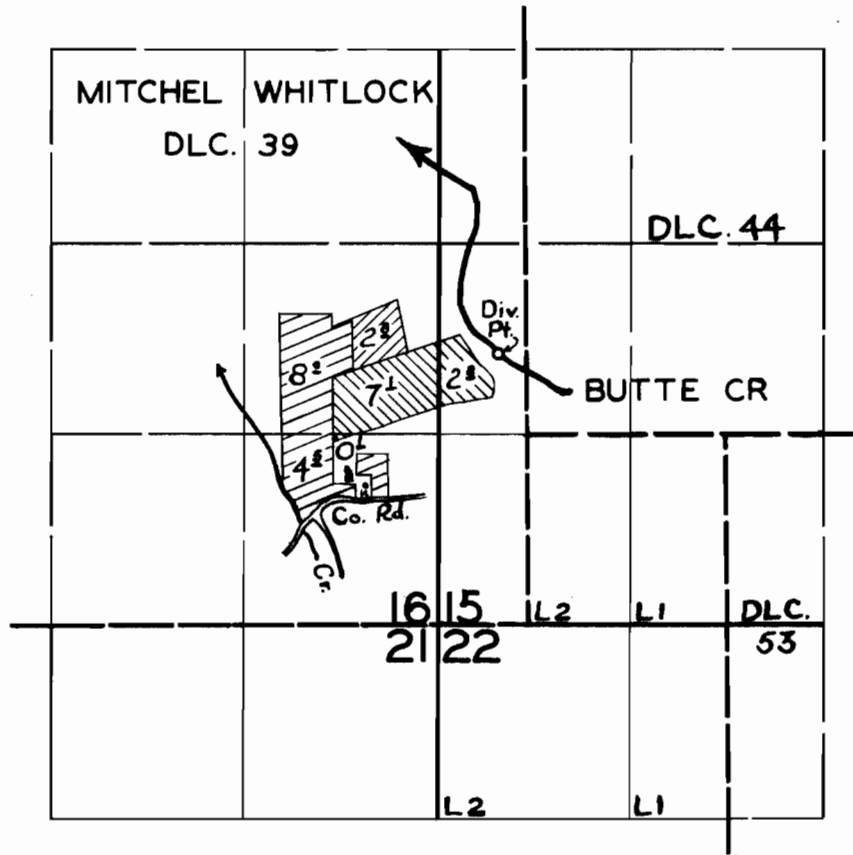

FINAL PROOF SURVEY

27394 UNDER 21559 - 
 28115 22131 -
 Application No. 29478 Permit No. 23192 -

IN NAME OF

.....JAMES NICHOLSON.....

Surveyed 18 JULY 1956, by M. BISH.....