


T. 7S. R. 1W. W.M.

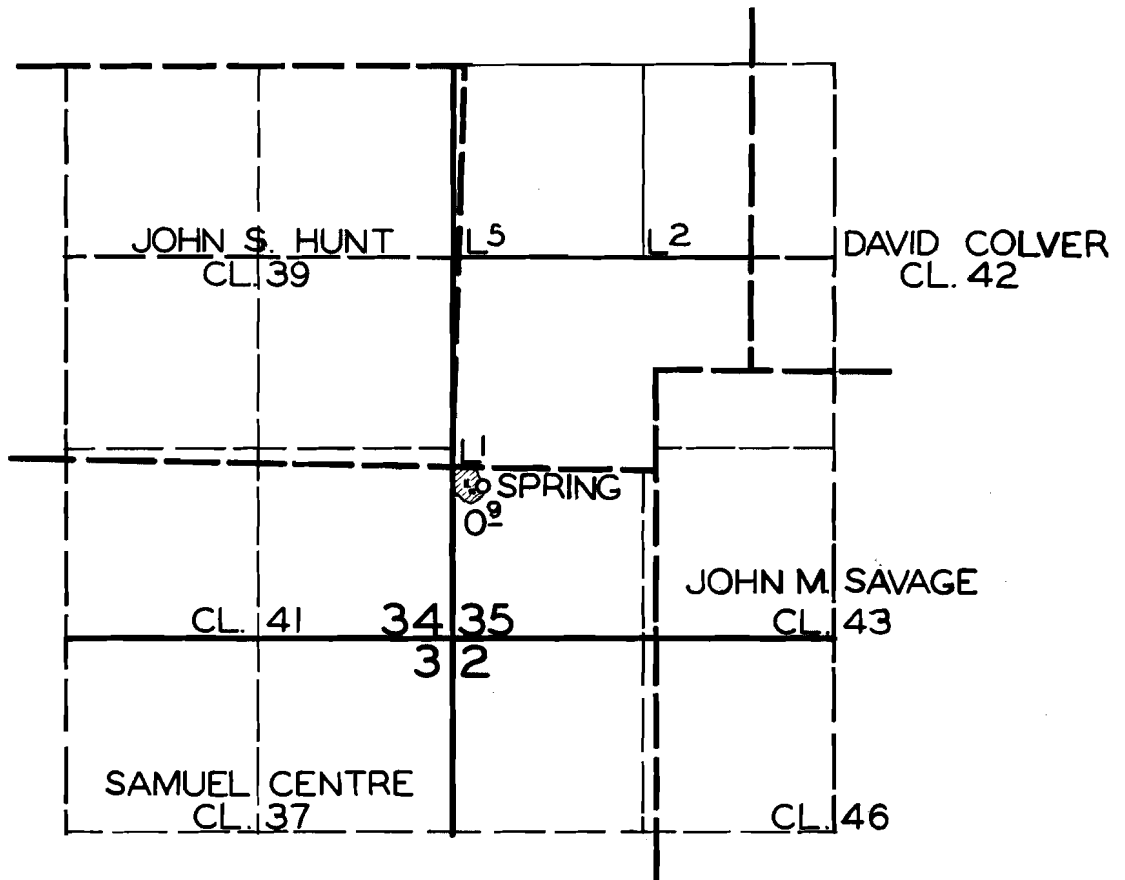

FINAL PROOF SURVEY

UNDER

Application No. 27506 Permit No. 21644

IN NAME OF

A. N. DOERFLER

Surveyed 1 MAR. 1956, by M. BISH