


T.5S. R.4 W.W.M.

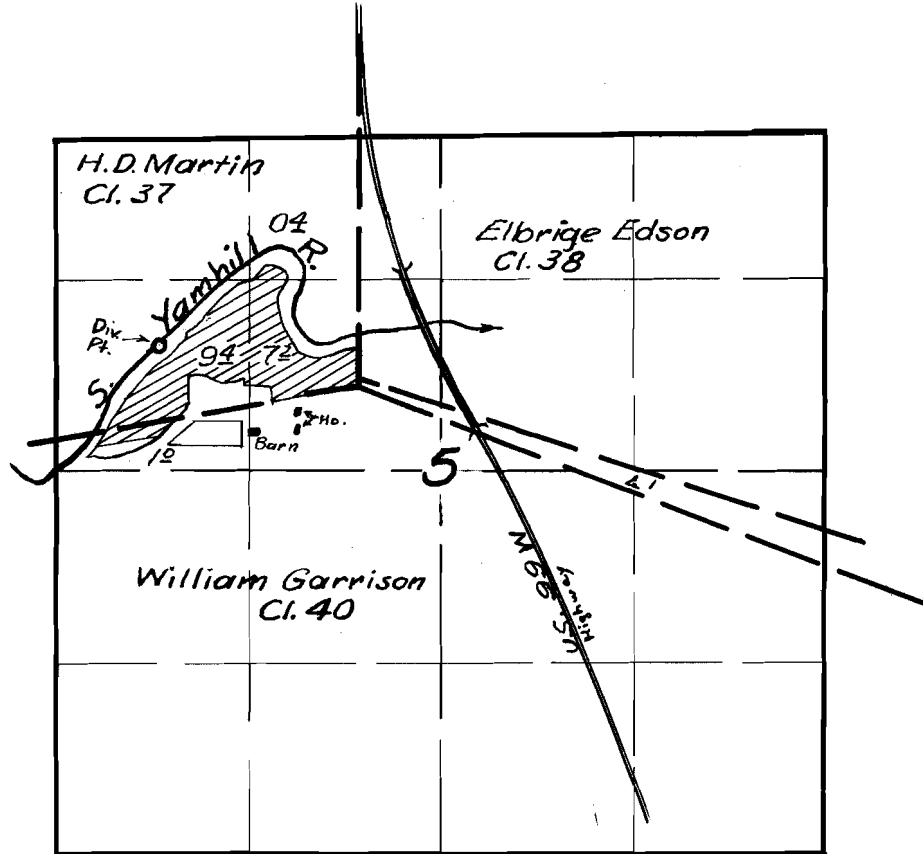

FINAL PROOF SURVEY

UNDER

Application No. *27827* Permit No. *21888*

IN NAME OF

M. Swartzentruber

Surveyed *Mar. 15* 1956, by *M. B. Fish*