


T.27S. R.6W.W.M.

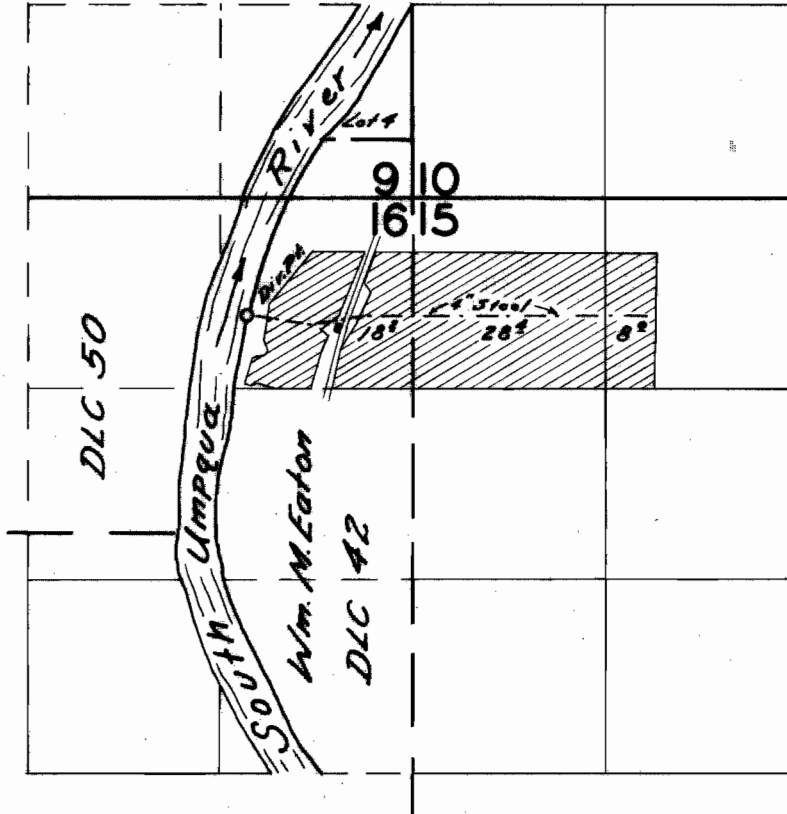

FINAL PROOF SURVEY
UNDER

Application No. 27707 Permit No. 21944
IN NAME OF

R.H. Kostings & Oscar N. Pedenbo

Surveyed Aug. 6 1956, by C.O. Bartels