


T. 5S. R. 2E. W.M.

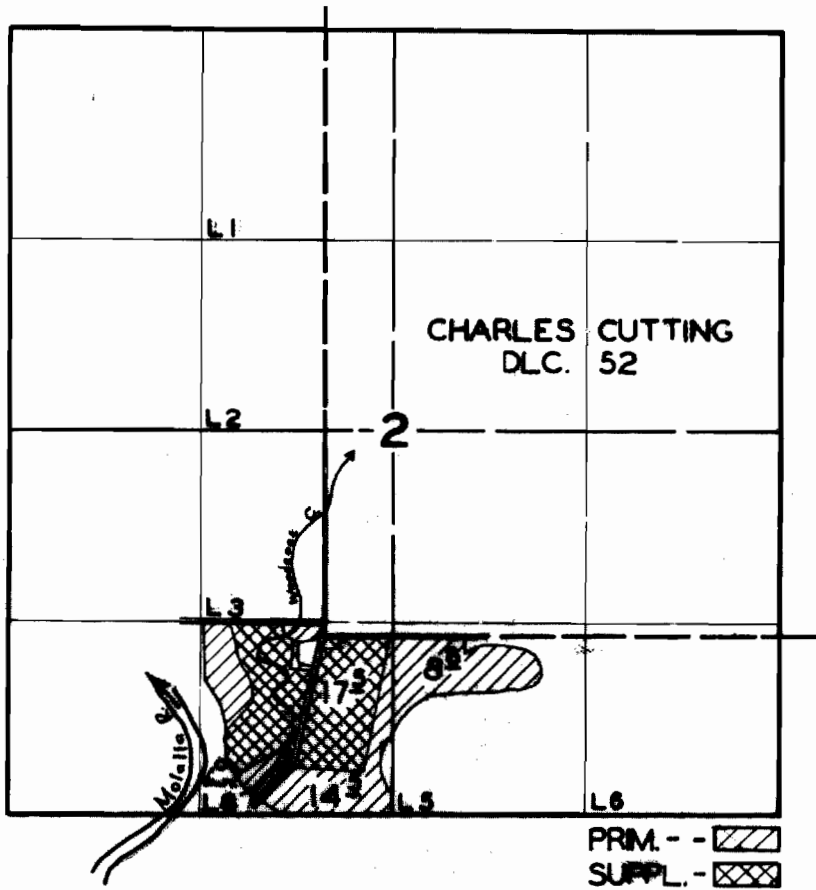

FINAL PROOF SURVEY
UNDER

Application No. 28105 Permit No. 22124
IN NAME OF

ALBERT M. THRONSON

Surveyed 15 MAR. 1956, by R.D. BEST

Best