



T. 6 S. R. 1 E. W.M.

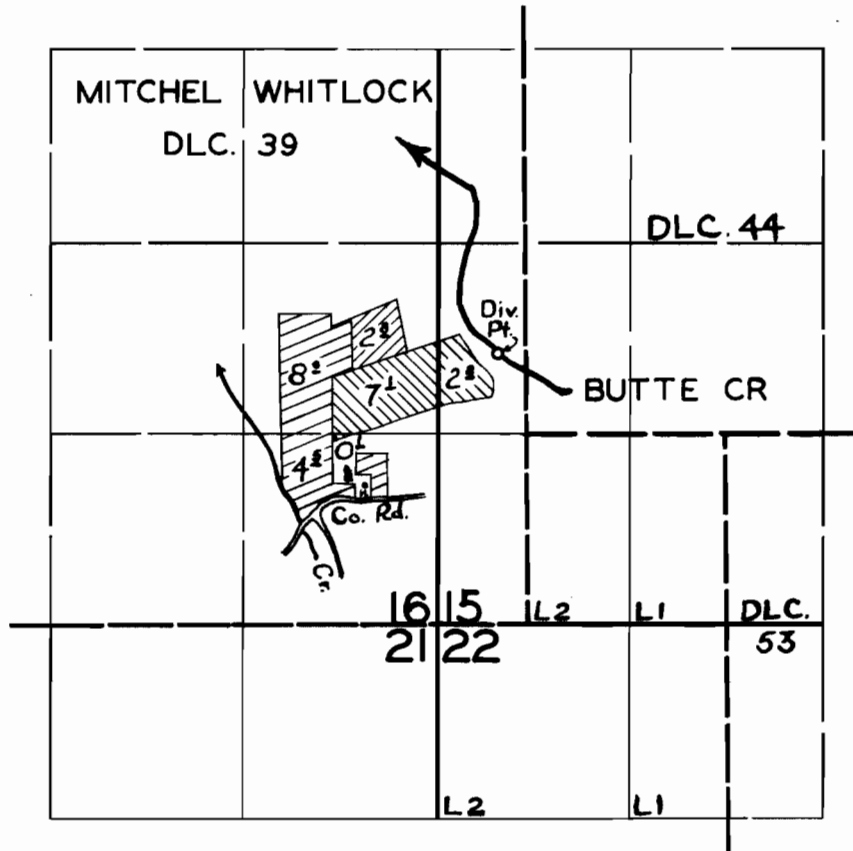

### FINAL PROOF SURVEY

27394 UNDER 21559 -   
28115 22131 -  
Application No. 29478 Permit No. 23192 -

IN NAME OF

JAMES NICHOLSON

Surveyed 18 JULY 1956, by M. BISH