


T.25S. R.7W.W.M.

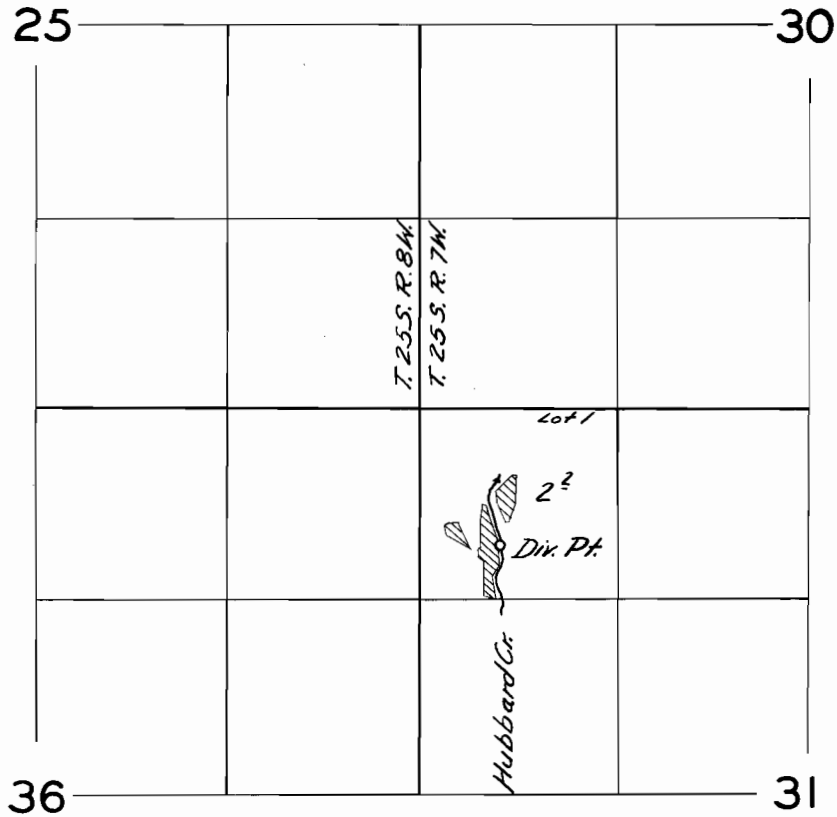

FINAL PROOF SURVEY

UNDER

Application No. 28262 Permit No. 22227...

IN NAME OF

Henry S. & Ella Teller

Surveyed Aug 25 1956, by C.O. Bartels