


T. 22S. R. 5W.W.M.

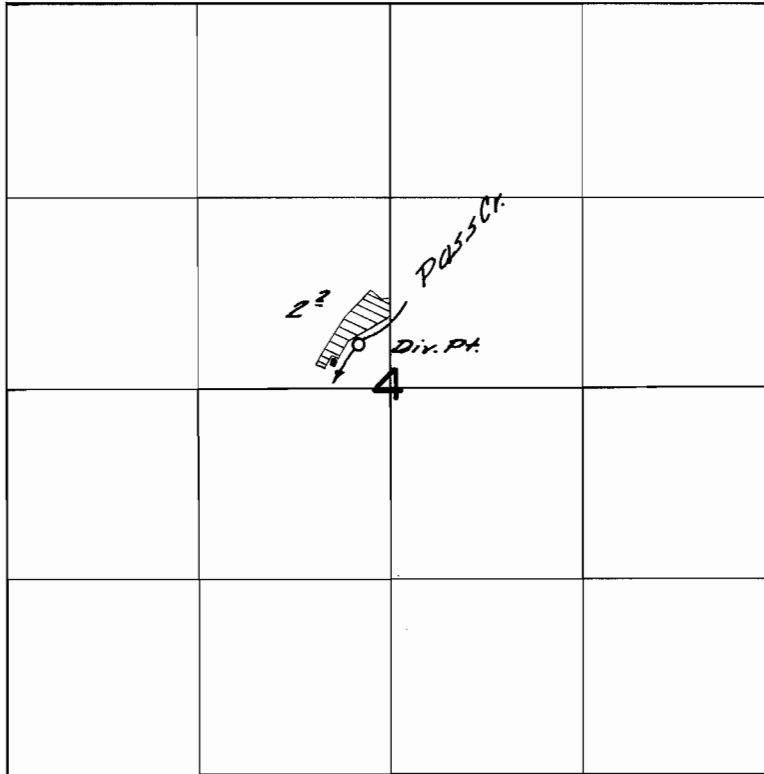

FINAL PROOF SURVEY

UNDER

Application No. 28921 Permit No. 22275

IN NAME OF

Roy Haldeman

Surveyed June 25, 1956, by C.O. Bartels