


T. 5 S. R. 4 W. W. M.

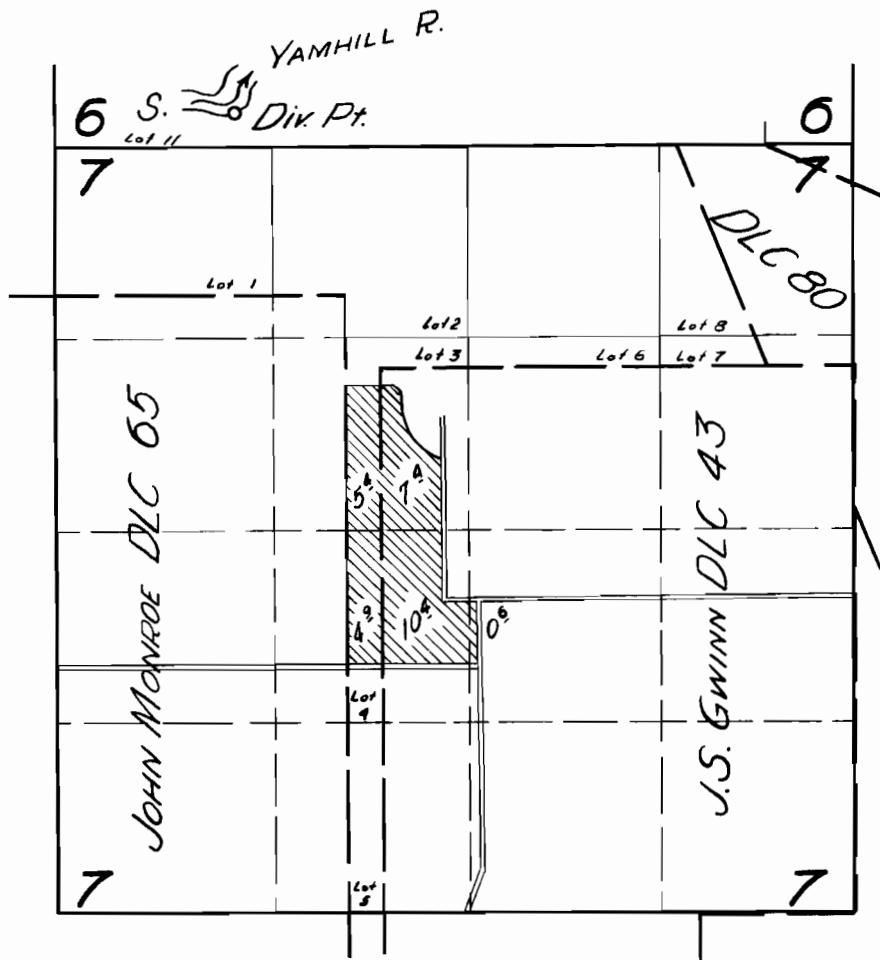

FINAL PROOF SURVEY

UNDER

Application No. 27312 Permit No. 22343

IN NAME OF

HAROLD W. HELLER

Surveyed 21 Mar 1950, by *C. A. Wilby*