


T.4S.R.4W.WM

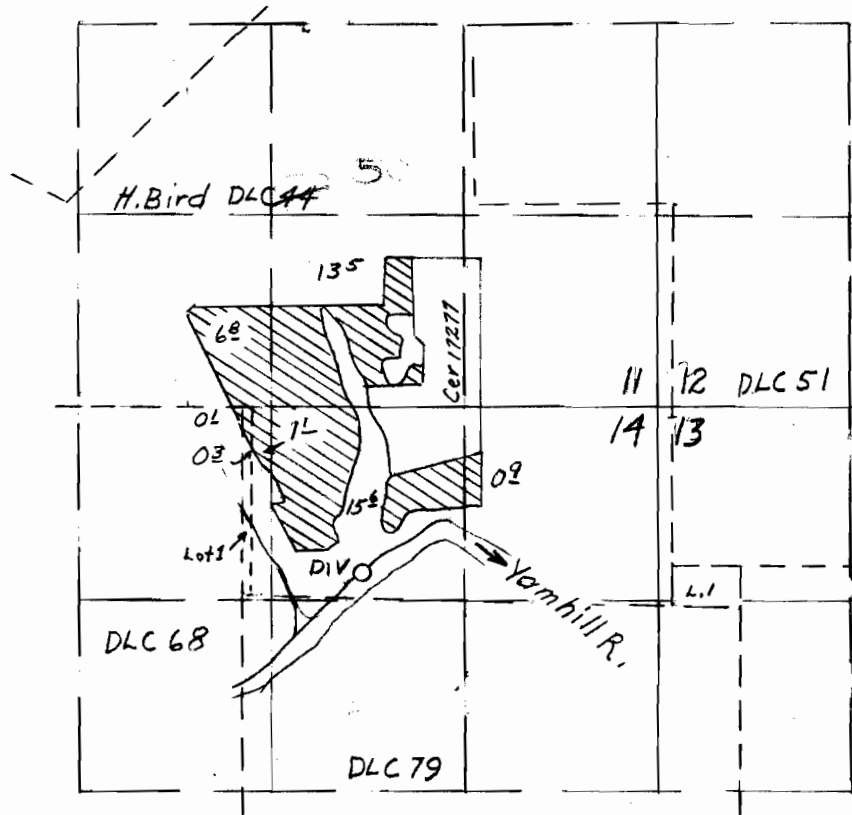

FINAL PROOF SURVEY

Under

Application No. 28374 Permit 22457

In name of

W.D. Warmington

Surveyed Sept 21, 1956 by R.H. Whitby