


T.2 N. R. 6 E. W. M.

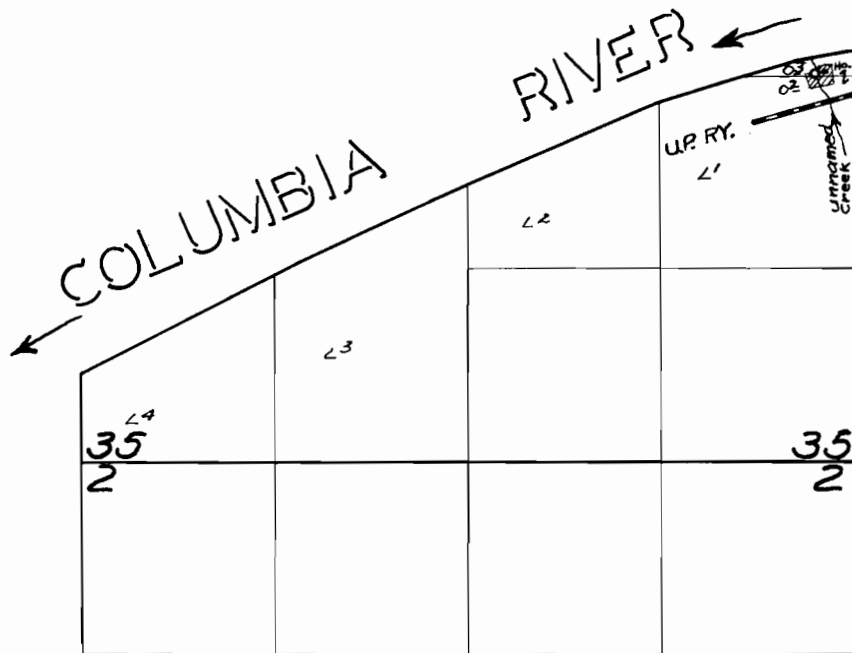

**FINAL PROOF SURVEY**

UNDER

Application No. 28657. Permit No. 22570.

IN NAME OF

Allen C. Park

Surveyed 1 Aug. 1956 by Tom Bish