


T. 6S. R. 3W.W.M.

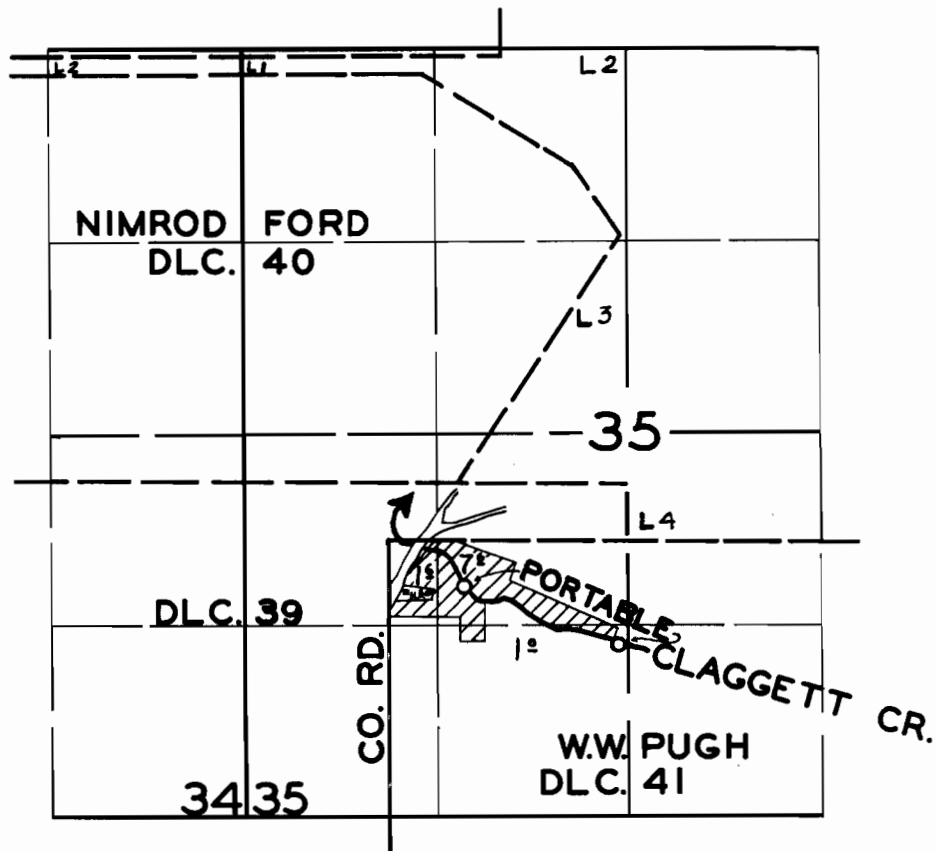

FINAL PROOF SURVEY

UNDER

Application No. **28797** Permit No. **22665**

IN NAME OF

OSCAR T. BOWEN

Surveyed **3 JULY 1956**, by **M. BISH**