


T. 5 E 6 S. R. 6 W. W.M.

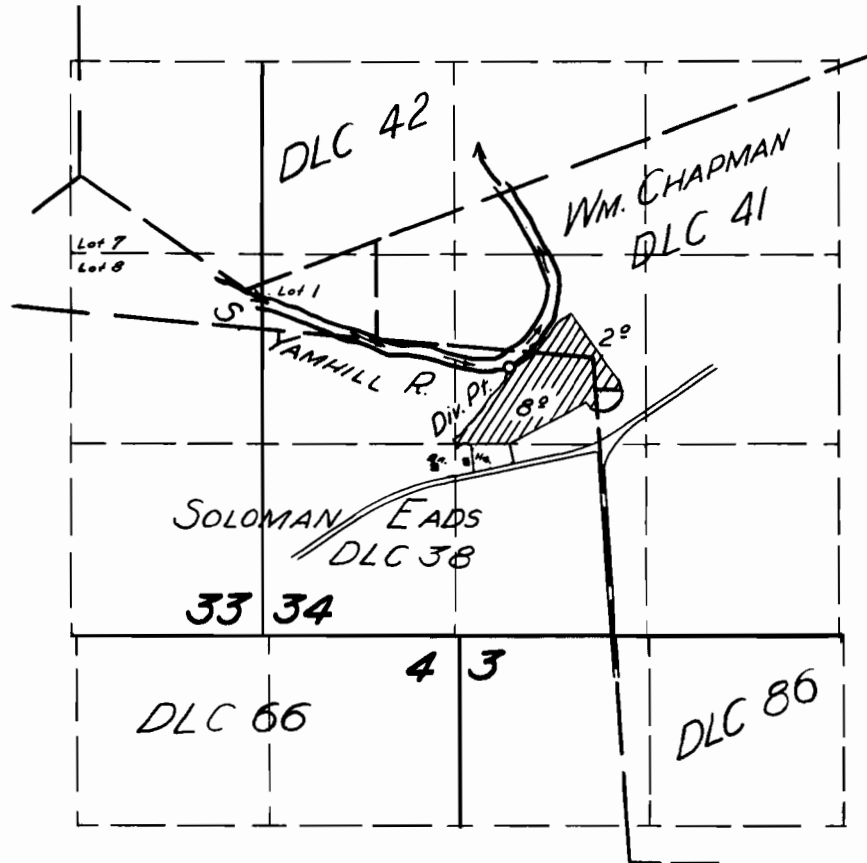

FINAL PROOF SURVEY
UNDER

Application No. 28835 Permit No. 22689
IN NAME OF

CARL E. YODER

Surveyed 14 Mar. 1956, by

C. R. [Signature]