


T.5 S. R. 4 W.W.M.

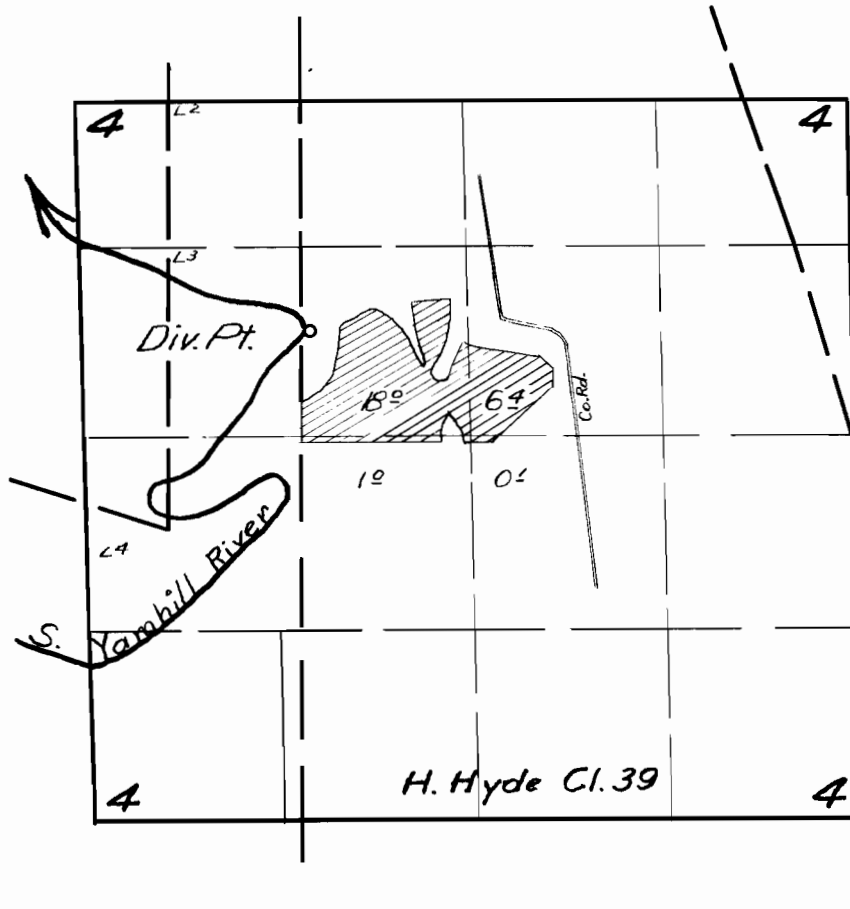

FINAL PROOF SURVEY

UNDER

Application No. 29748 Permit No. 23431

IN NAME OF

Samuel A. & Clara Weaver

Surveyed Mar. 15 1956, by M. Besh