


T.29S. R.5W.W.M.

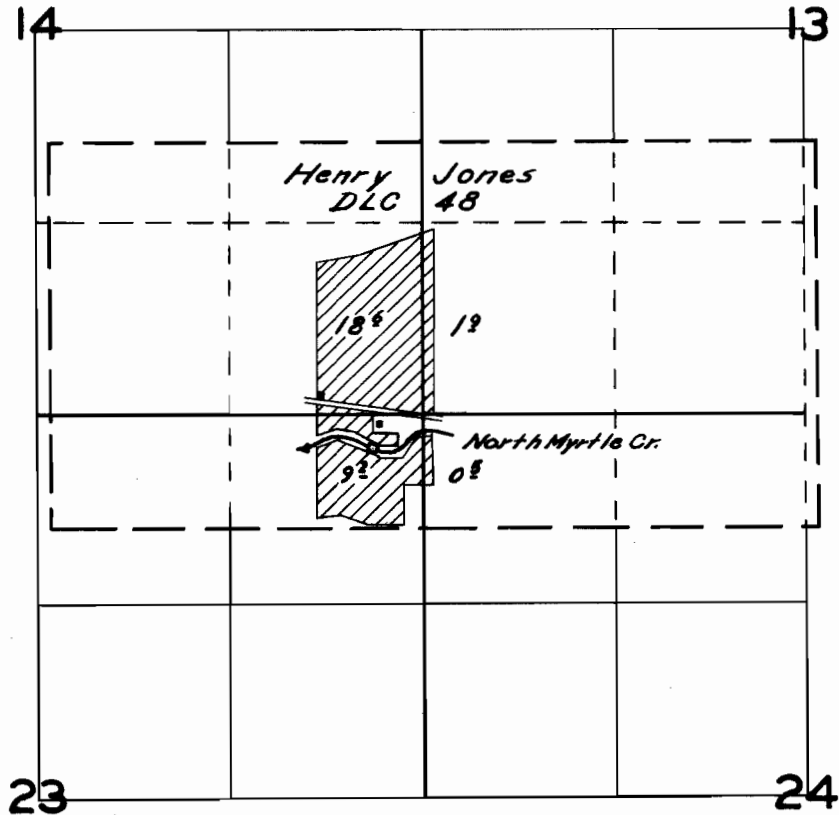

**FINAL PROOF SURVEY**  
UNDER

Application No. 29909 Permit No. 23579  
IN NAME OF

W. J. B. & Golda Dieckman

Surveyed Aug. 29 1956, by C. O. Bartals