


T. 7 S. R. 1 W. W. M.

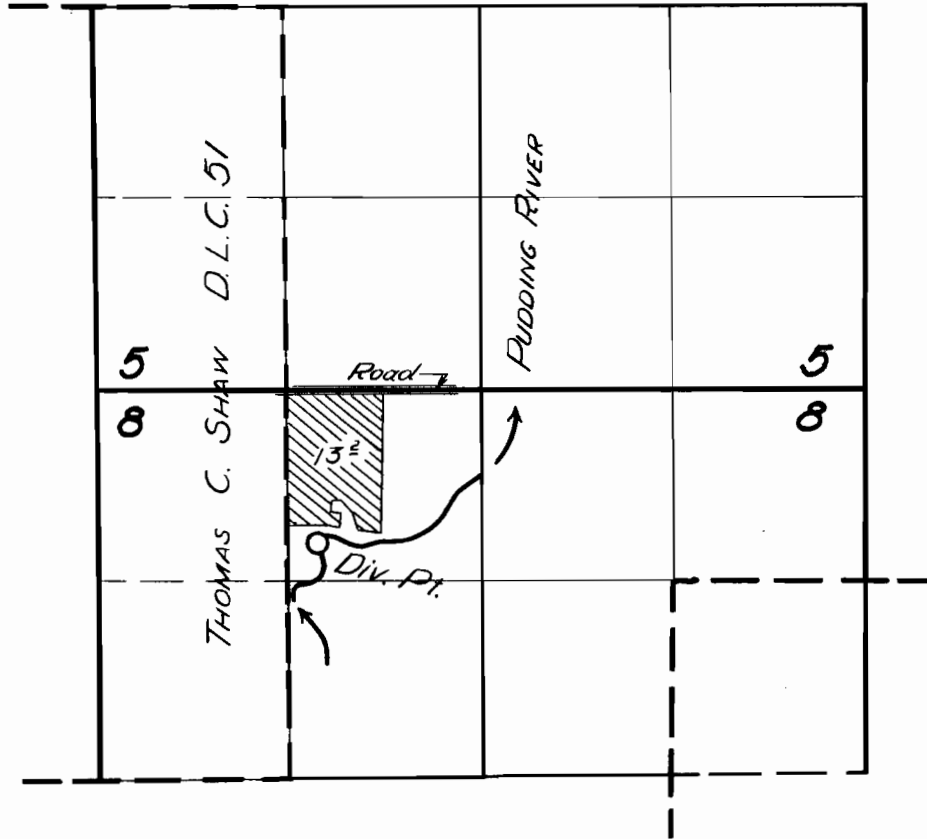

**FINAL PROOF SURVEY**  
UNDER

Application No. 21702 Permit No. 17042

IN NAME OF

**HARVEY LINCOLN**

Surveyed 16 May 1955, by T. JONES

(C67B)

1955-Z