


T.9 S.R. 3 W. W.M.

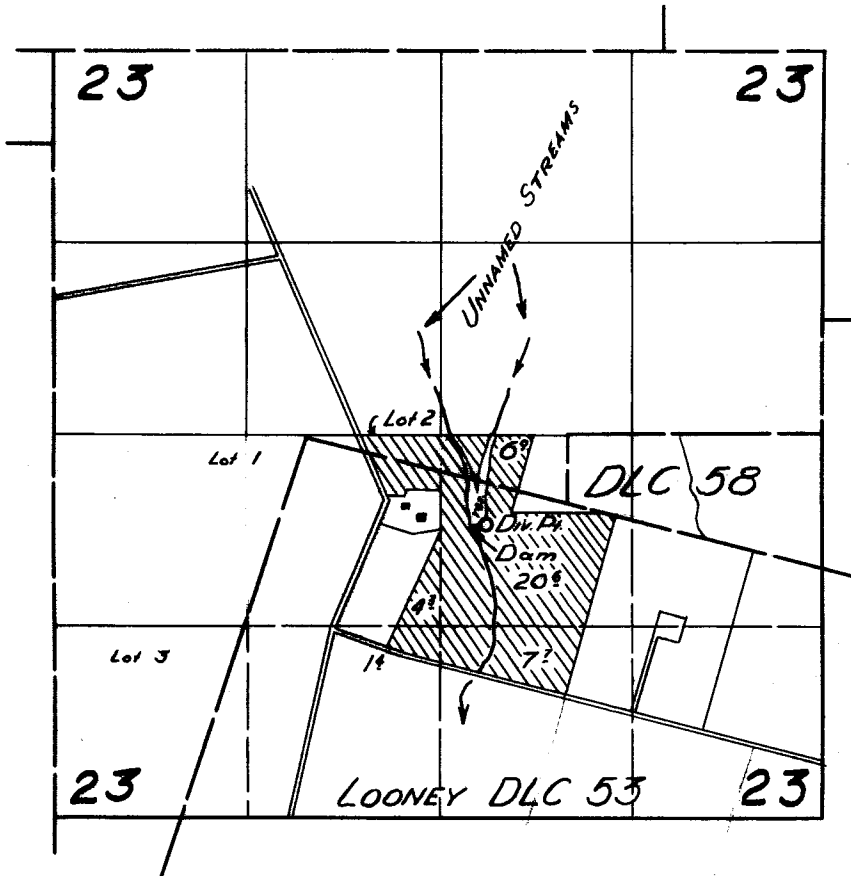

FINAL PROOF SURVEY

UNDER
R-22779

R-910

Application No. 22780 Permit No. 18035

IN NAME OF

JAKE W. GILMOUR

Surveyed 6 April 1956, by