


T. 7S. R. 1W.W.M.

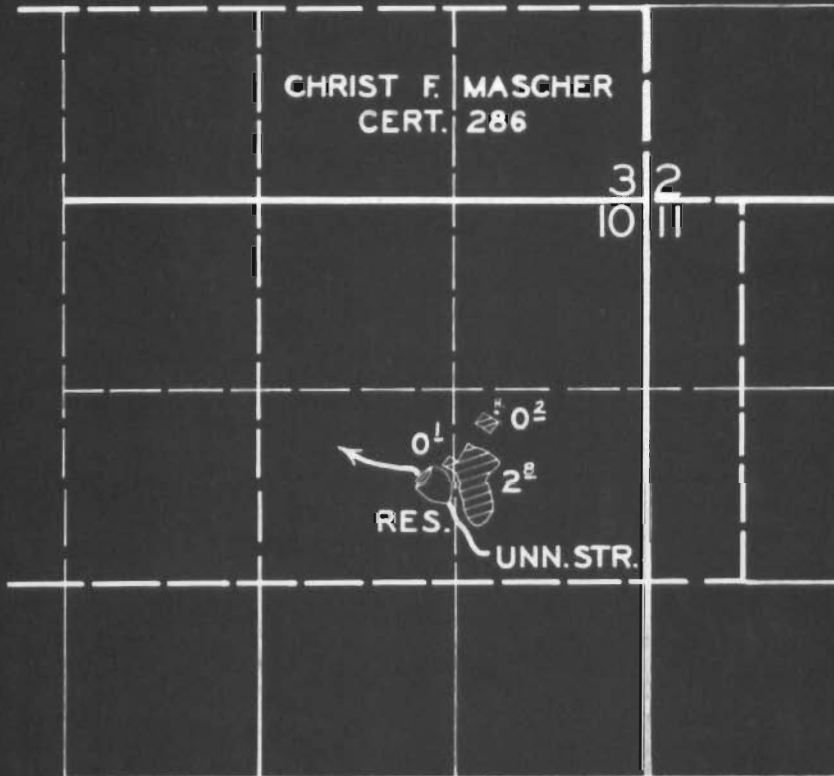

FINAL PROOF SURVEY

UNDER

Application No. 24452 | Permit No. 19276
R-24451 | R-1015

IN NAME OF

A. C. SCOTT

Surveyed 1 MAR. 1956, by M. BISH