


T. 4 S. R. 1 W. W. M.

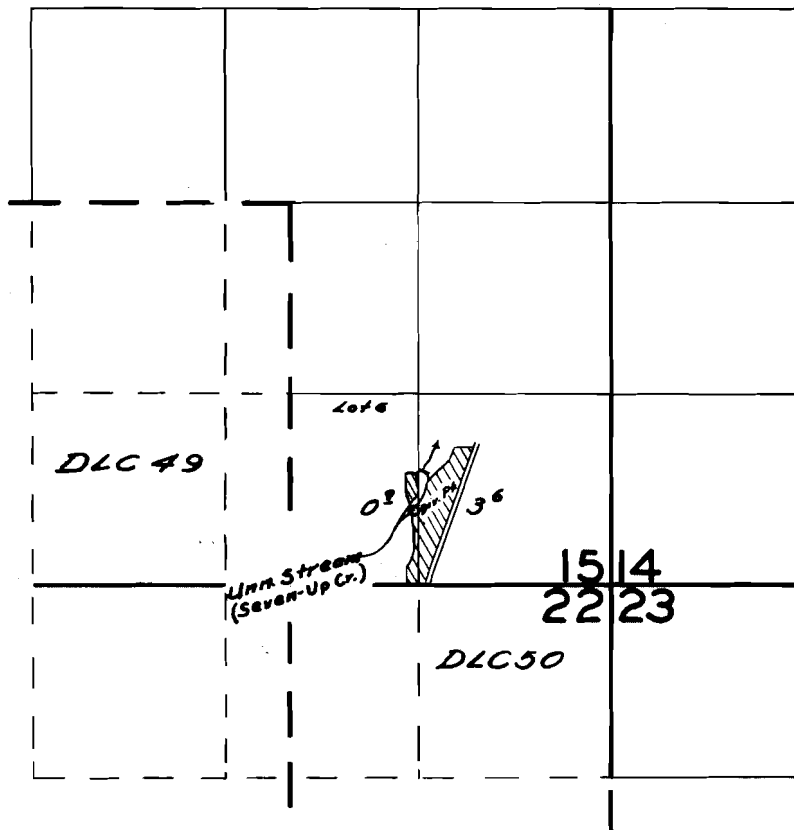

FINAL PROOF SURVEY

UNDER

Application No. *R-25165* *25166* Permit No. *R-1074* *12722*

IN NAME OF

Richard H. & Clara Pearl Pence

Surveyed *June 1, 1956*, by *G. O. Bartels*